



西部第5地区土地区画整理事業 出来形確認測量（原子図）

2街区

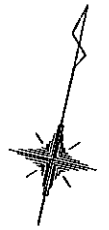

S = 1 / 500

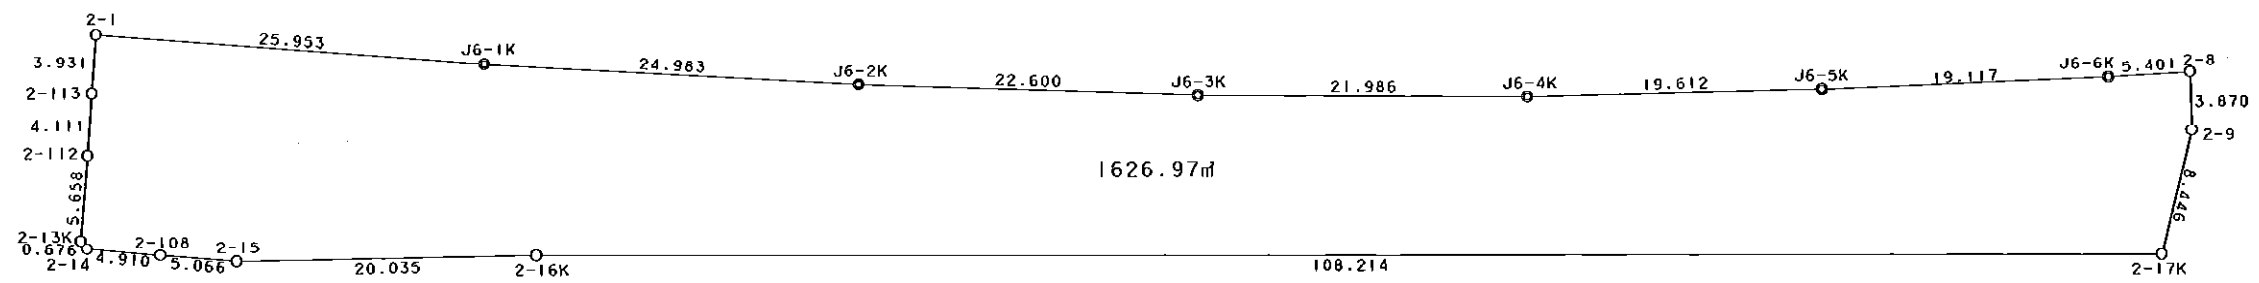

凡 例

記号	名称
⊙	地区界点
○	街区点
○	画地点(折れ点)
┆	画地点(直線中)

地番
2-1

筆種別
筆界
合計

面積
1626.97
1626.97

坪数
492.15
492.15

面積 (座標法) 計算書

地番 = 2-1
測点名

	[1] X (i)	[2] X (i+1)-X (i-1)	[3] Y (i)	[4] Y (i+1)-Y (i-1)	[2] * [3]	[1] * [4]	方向角	夾 角	距 離
2-1	-149602.147	-7.836	-41693.664	-25.051	326711.551104	3747683.384497	171-14-06	89-59-30	3.931
2-113	-149606.032	-7.945	-41693.065	1.242	331251.401425	-185810.691744	171-00-02	179-45-56	4.111
2-112	-149610.092	-9.655	-41692.422	1.485	402540.334410	-222170.986620	171-26-30	180-26-28	5.658
2-13K	-149615.687	-6.009	-41691.580	1.376	250524.704220	-205871.185312	127-47-09	136-20-39	0.676
2-14	-149616.101	0.286	-41691.046	5.394	-11923.639156	-807029.248794	81-48-14	134-01-05	4.910
2-108	-149615.401	1.460	-41686.186	9.869	-60861.831560	-1476554.392469	81-22-21	179-34-07	5.066
2-15	-149614.641	5.651	-41681.177	24.438	-235540.331227	-3656282.596758	75-52-12	174-29-51	20.035
2-16K	-149609.750	29.262	-41661.748	124.863	-1219106.069976	-18680722.214250	76-59-05	181-06-53	108.214
2-17K	-149585.379	32.816	-41556.314	105.560	-1363712.000224	-15790232.607240	0-51-17	103-52-12	8.446
2-9	-149576.934	12.186	-41556.188	-0.864	-506403.706968	129234.470976	345-10-38	164-19-21	3.870
2-8	-149573.193	2.202	-41557.178	-6.167	-91508.905956	922417.881231	253-26-39	88-16-01	5.401
J6-6K	-149574.732	-6.615	-41562.355	-23.608	274934.978325	3531160.273056	254-36-08	181-09-29	19.117
J6-5K	-149579.808	-9.934	-41580.786	-37.432	413063.528124	5599071.373056	255-39-30	181-03-22	19.612
J6-4K	-149584.666	-9.679	-41599.787	-40.452	402644.338373	6050998.909032	257-20-01	181-40-31	21.986
J6-3K	-149589.487	-9.222	-41621.238	-43.618	383831.056836	6524794.243966	258-46-14	181-26-13	22.600
J6-2K	-149593.888	-8.709	-41643.405	-46.776	362672.414145	6997403.705088	260-04-14	181-18-00	24.983
J6-1K	-149598.196	-8.259	-41668.014	-50.259	344136.127626	7518655.732764	261-14-36	181-10-22	25.953
合計					3253.949521	-3253.949521			304.569
				倍面積	1626.97	1626.97			
				面積					