


西部第5地区土地区画整理事業 出来形確認測量 (原子凶)

18街区

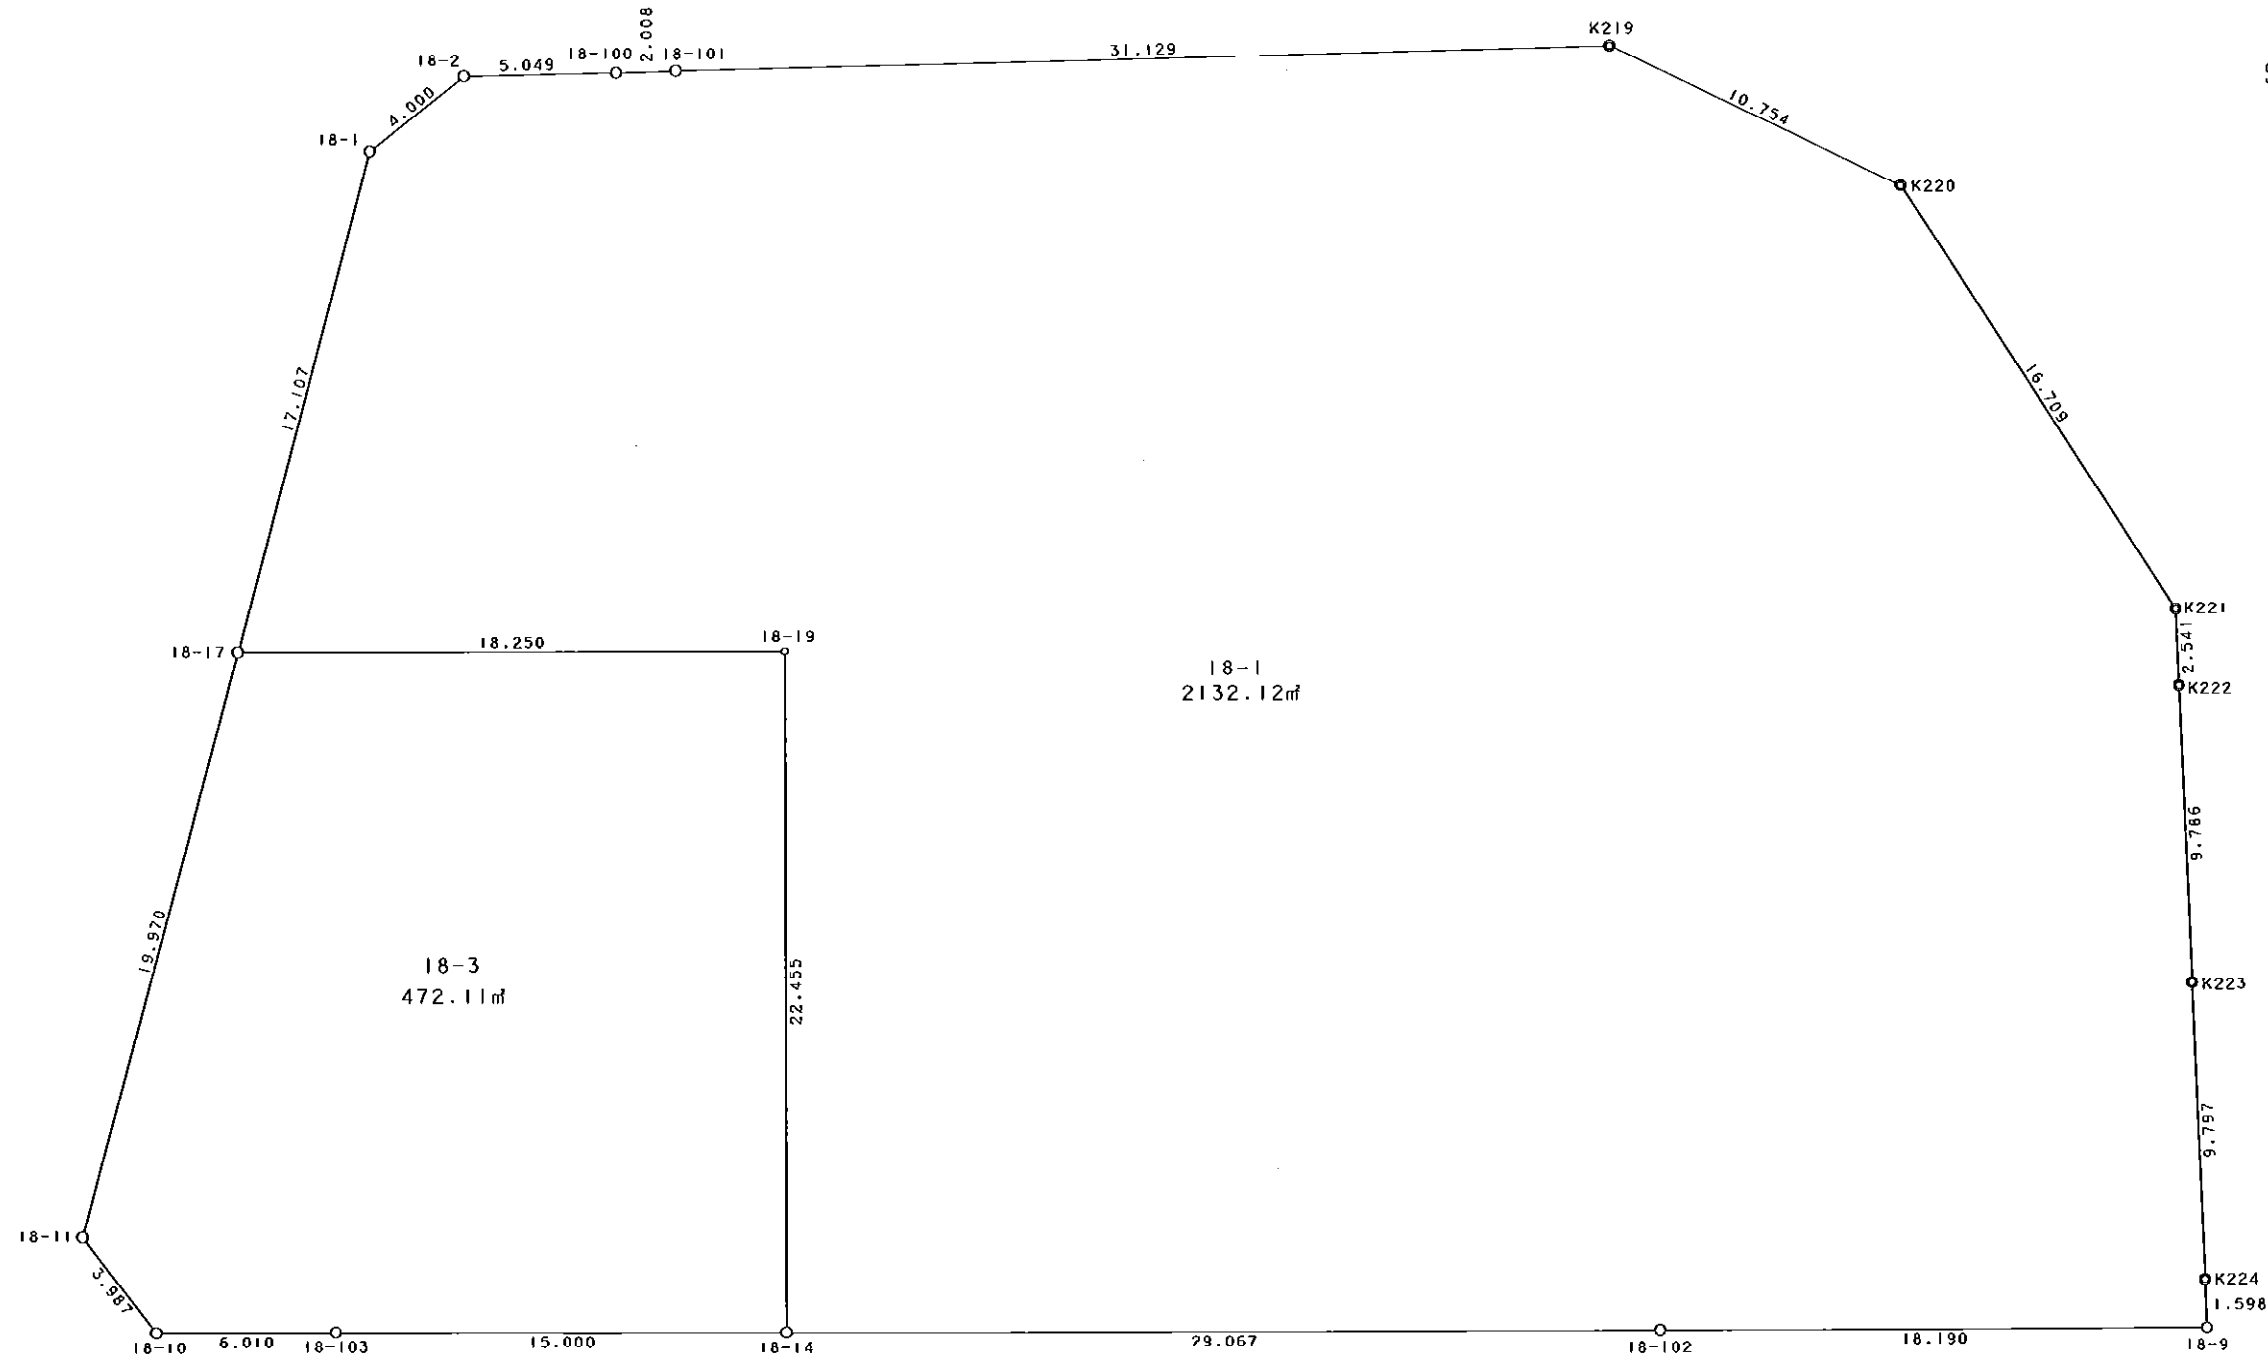

S = 1 / 250



凡 例

| 記号 | 名称        |
|----|-----------|
| ◎  | 地区界点      |
| ○  | 街区点       |
| ○  | 画地点 (折れ点) |
| ┆  | 画地点 (直線中) |

地番  
18-1  
18-3

筆種別  
筆界  
筆界  
筆合計

面積  
2132.12  
472.11  
2604.23

坪数  
644.96  
142.81  
787.77

面積 (座標法) 計算書

地番 = 18-1  
測点名

|        | [1]<br>X (i) | [2]<br>X (i+1)-X (i-1) | [3]<br>Y (i) | [4]<br>Y (i+1)-Y (i-1) | [2] * [3]              | [1] * [4]               | 方向角       | 夾 角       | 距 離     |
|--------|--------------|------------------------|--------------|------------------------|------------------------|-------------------------|-----------|-----------|---------|
| 18-2   | -149863.386  | -3.178                 | -41482.059   | -7.981                 | 131829.983502          | 1196059.683666          | 227-37-27 | 143-06-08 | 4.000   |
| 18-1   | -149866.082  | -19.497                | -41485.014   | -6.178                 | 808833.317958          | 925872.654596           | 190-51-34 | 143-14-07 | 17.107  |
| 18-17  | -149882.883  | -15.450                | -41488.237   | 14.977                 | 640993.261650          | -2244795.938691         | 85-45-17  | 74-53-43  | 18.250  |
| 18-19  | -149881.532  | -21.044                | -41470.037   | 19.844                 | 872695.458628          | -2974249.121008         | 175-48-05 | 270-02-48 | 22.455  |
| 18-14  | -149903.927  | -20.266                | -41468.393   | 30.633                 | 840398.452538          | -4592006.995791         | 85-47-59  | 89-59-54  | 29.067  |
| 18-102 | -149901.798  | 3.477                  | -41439.404   | 47.129                 | -144084.807708         | -7064721.837942         | 85-45-00  | 179-57-01 | 18.190  |
| 18-9   | -149900.450  | 2.937                  | -41421.264   | 17.973                 | -121654.252368         | -2694160.787850         | 354-00-01 | 88-15-01  | 1.598   |
| K224   | -149898.861  | 11.324                 | -41421.431   | -1.270                 | -469056.284644         | 190371.553470           | 353-32-09 | 179-32-08 | 9.797   |
| K223   | -149889.126  | 19.458                 | -41422.534   | -2.212                 | -805999.666572         | 331554.746712           | 353-29-35 | 179-57-26 | 9.786   |
| K222   | -149879.403  | 12.247                 | -41423.643   | -1.400                 | -507315.355821         | 209831.164200           | 353-25-24 | 179-55-49 | 2.541   |
| K221   | -149876.879  | 15.832                 | -41423.934   | -10.395                | -655823.723088         | 1557970.157205          | 322-47-34 | 149-22-10 | 16.709  |
| K220   | -149863.571  | 17.221                 | -41434.038   | -20.121                | -713535.568398         | 3015404.912091          | 291-20-15 | 148-32-41 | 10.754  |
| K219   | -149859.658  | 0.871                  | -41444.055   | -40.997                | -36097.771905          | 6143796.399026          | 264-23-31 | 153-03-16 | 31.129  |
| 18-101 | -149862.700  | -3.246                 | -41475.035   | -32.978                | 134627.963610          | 4942172.120600          | 264-10-13 | 179-46-42 | 2.008   |
| 18-100 | -149862.904  | -0.686                 | -41477.033   | -7.024                 | 28453.244638           | 1052637.037696          | 264-31-19 | 180-21-06 | 5.049   |
| 合計     |              |                        |              | 倍面積<br>面積              | 4264.252020<br>2132.12 | -4264.252020<br>2132.12 |           |           | 198.440 |

面積 (座標法) 計算書

地番 = 18-3  
測点名

|        | [1]<br>X (i) | [2]<br>X (i+1)-X (i-1) | [3]<br>Y (i) | [4]<br>Y (i+1)-Y (i-1) | [2] * [3]            | [1] * [4]             | 方向角       | 夾 角       | 距 離    |
|--------|--------------|------------------------|--------------|------------------------|----------------------|-----------------------|-----------|-----------|--------|
| 18-17  | -149882.883  | -20.963                | -41488.237   | -21.965                | 869717.912231        | 3292177.525095        | 190-52-02 | 105-06-45 | 19.970 |
| 18-11  | -149902.495  | -22.586                | -41492.002   | -1.109                 | 937138.357172        | 166241.866955         | 138-13-58 | 127-21-56 | 3.987  |
| 18-10  | -149905.469  | -2.514                 | -41489.346   | 8.648                  | 104304.215844        | -1296382.495912       | 85-36-36  | 127-22-38 | 6.010  |
| 18-103 | -149905.009  | 1.542                  | -41483.354   | 20.953                 | -63967.331868        | -3140959.653577       | 85-51-49  | 180-15-13 | 15.000 |
| 18-14  | -149903.927  | 23.477                 | -41468.393   | 13.317                 | -973553.462461       | -1996270.595859       | 355-48-05 | 89-56-16  | 22.455 |
| 18-19  | -149881.532  | 21.044                 | -41470.037   | -19.844                | -872695.458628       | 2974249.121008        | 265-45-17 | 89-57-12  | 18.250 |
| 合計     |              |                        |              | 倍面積<br>面積              | 944.232290<br>472.11 | -944.232290<br>472.11 |           |           | 85.672 |