

面積集計表

平成19年6月14日

現場名: 平成18年度出来形確認測量


所有者	No.	地番No	地番名	面積	地積	坪数
	1	601	34BL1LOT	120.5248300	120.52	36.45
	2	602	34BL2LOT	12.0312735	12.03	3.63
	3	603	34BL3LOT	123.0525260	123.05	37.22
	4	604	34BL4LOT	256.6411900	256.64	77.63
	5	605	34BL5LOT	8.2392860	8.23	2.49
	6	606	34BL6LOT	224.8581640	224.85	68.01
	7	607	34BL7LOT	47.5669320	47.56	14.38
	8	608	34BL8LOT	191.9027930	191.90	58.05
	9	609	34BL9LOT	33.8892870	33.88	10.25
	10	610	34BL10LOT	200.3995700	200.39	60.62
	11	611	34BL11LOT	117.1728635	117.17	35.44
	12	612	34BL13LOT	40.7807945	40.78	12.33
	13	613	34BL14LOT	49.0208770	49.02	14.82
	14	614	34BL15LOT	247.2212405	247.22	74.78
	15	615	34BL16LOT	245.9711330	245.97	74.40
	16	616	34BL17LOT	29.8763540	29.87	9.03
	17	617	34BL18LOT	38.8250070	38.82	11.74
	18	618	34BL19LOT	71.4538840	71.45	21.61
	19	619	34BL20LOT	18.5483595	18.54	5.61
	20	620	34BL21LOT	92.9569920	92.95	28.11
	21	621	34BL22LOT	361.3987985	361.39	109.32
	22	622	34BL23LOT	21.1971305	21.19	6.41
	23	623	34BL24LOT	2.6927710	2.69	0.81
	24	624	34BL25LOT	308.6636020	308.66	93.37
合計			24筆	2864.8856585	2864.77	866.51

座標面積計算書

世界測地系

地番 34BL1LOT 地目

境界点	X座標	Y座標	辺長	方向角	備考
G34-1	-151142.698	-38778.895	3.985	54° 57' 43"	
G34-2	-151140.410	-38775.632	9.874	100° 36' 16"	
G34-3	-151142.227	-38765.927	10.473	190° 47' 30"	
G34-57	-151152.515	-38767.888	12.802	286° 29' 44"	
G34-37	-151148.880	-38780.163	3.137	11° 47' 24"	
G34-38	-151145.809	-38779.522	3.174	11° 23' 42"	

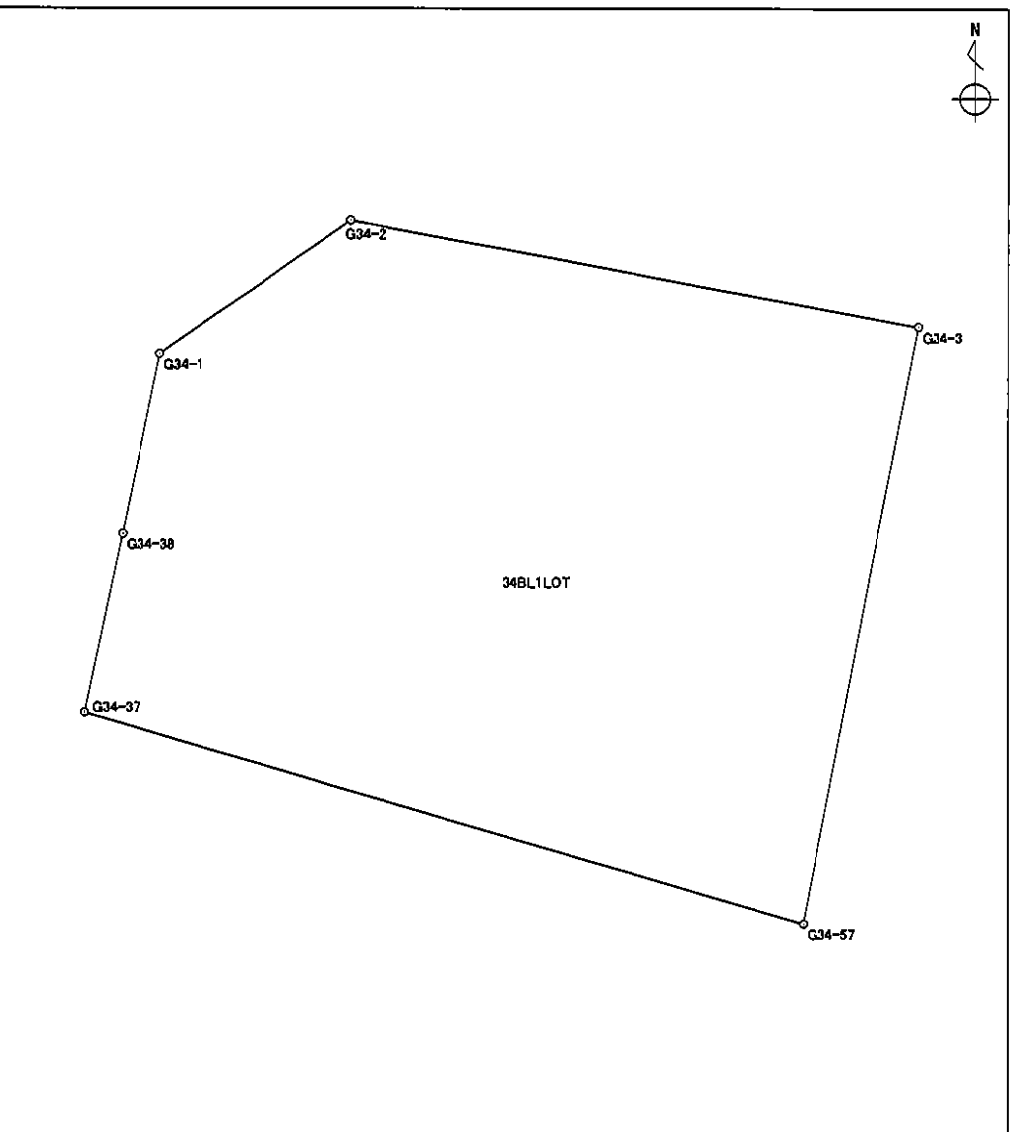


面積算出公式	面積	120.5248300	土地の所在
$A = \frac{1}{2} \sum X_n \times (Y_{n+1} - Y_{n-1})$	地積	120.52	土地の所有者

座標面積計算書

世界測地系

地番	34BL2LOT	地目	
----	----------	----	--

境界点	X 座標	Y 座標	辺長	方向角	備考
G34-3	-151142.227	-38765.927	0.986	100° 34' 49"	
G34-4	-151142.408	-38764.958	12.273	190° 47' 14"	
G34-41	-151154.464	-38767.255	0.558	289° 42' 08"	
G34-40	-151154.276	-38767.780	0.438	286° 41' 57"	
G34-39	-151154.150	-38768.200	1.665	10° 48' 13"	
G34-57	-151152.515	-38767.888	10.473	10° 47' 30"	

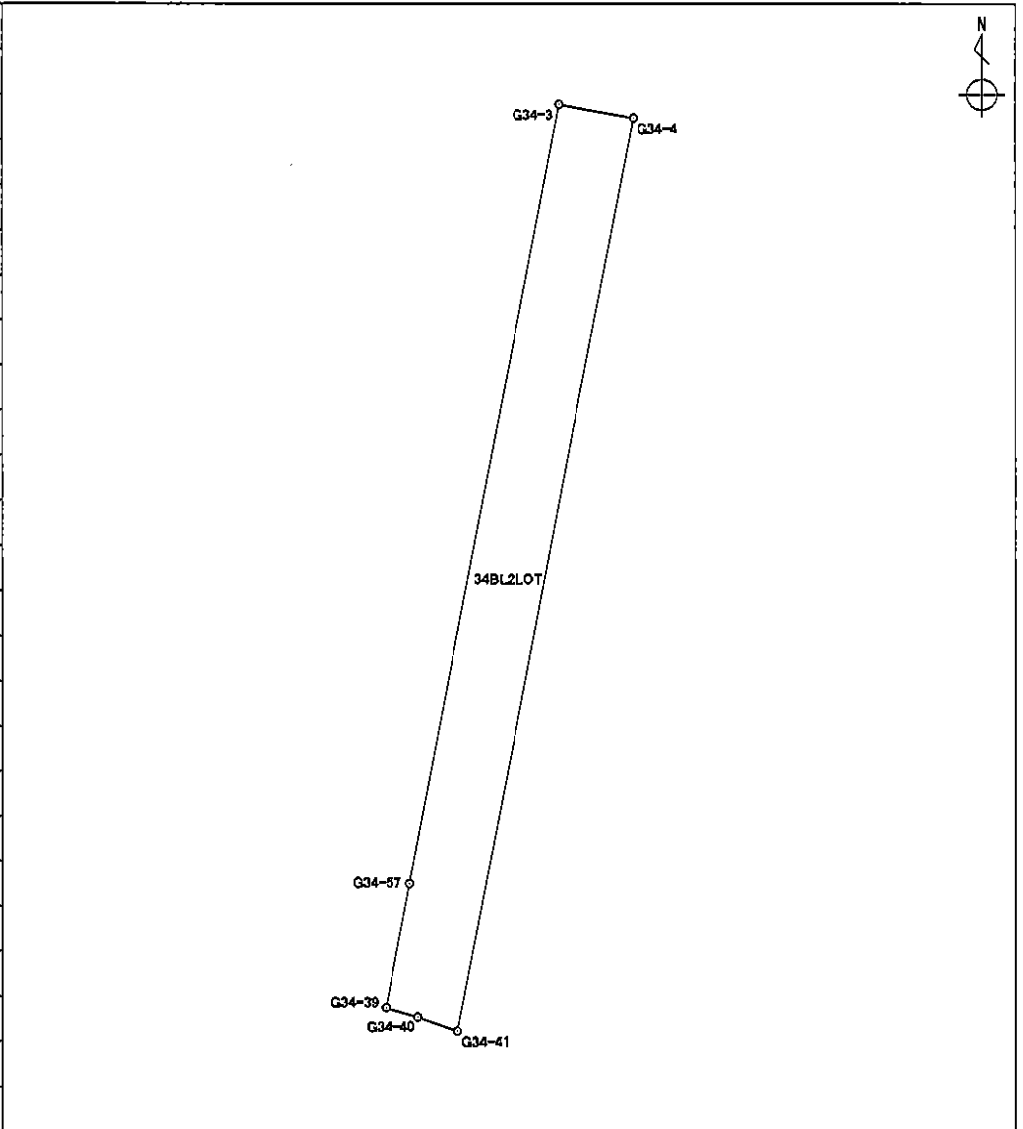


面積算出公式 $A = \frac{1}{2} \sum X_n \times (Y_{n+1} - Y_{n-1})$	面積	12.0312735	土地の所在
	地積	12.03	土地の所有者

座標面積計算書

世界測地系

地番 34BL3LOT 地目

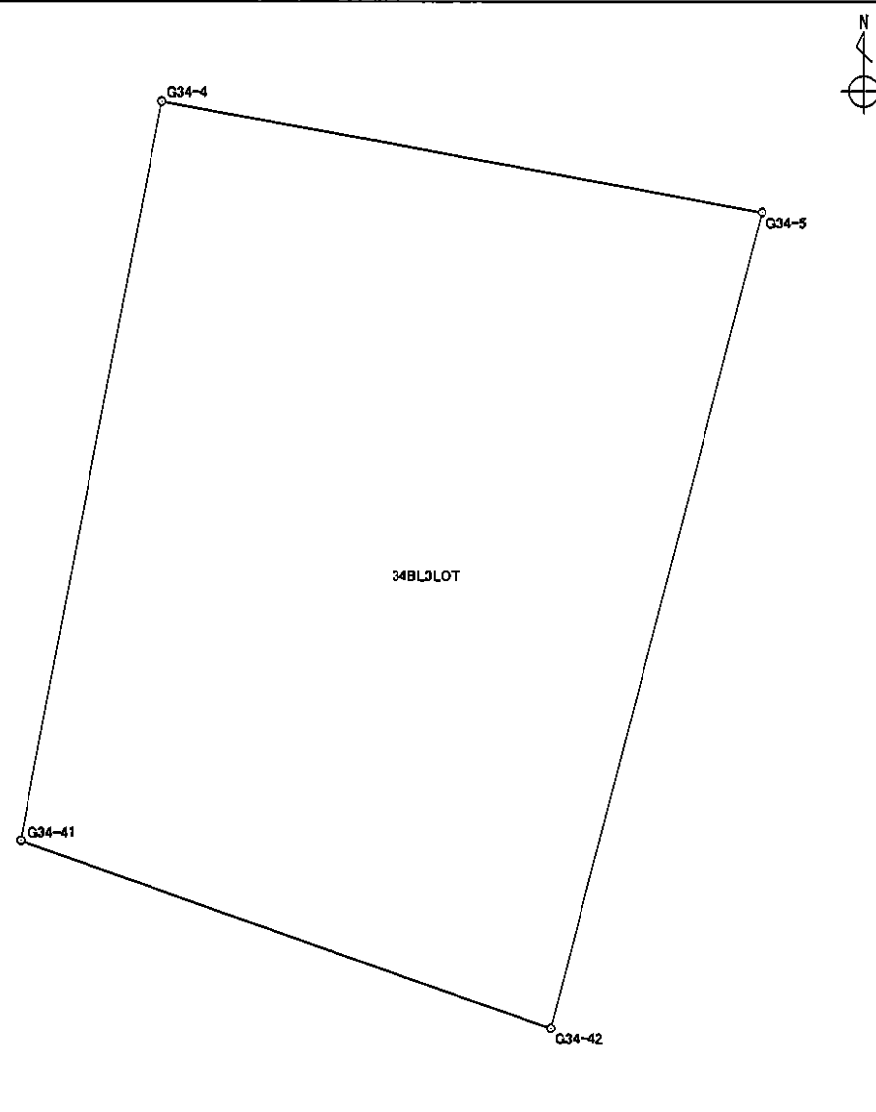
境界点	X 座標	Y 座標	辺長	方向角	備考			
G34-4	-151142.408	-38764.958	9.892	100° 36' 08"				
G34-5	-151144.228	-38755.235	13.743	194° 30' 01"				
G34-42	-151157.533	-38758.676	9.111	289° 41' 02"				
G34-41	-151154.464	-38767.255	12.273	10° 47' 14"				
面積算出公式					面積		123.0525260	土地の所在
$A = \frac{1}{2} \sum X_n \times (Y_{n+1} - Y_{n-1})$					地積		123.05	土地の所有者

座標面積計算書

世界測地系

地番	34BL4LOT	地目	
----	----------	----	--

境界点	X座標	Y座標	辺長	方向角	備考
G34-5	-151144.228	-38755.235	9.662	100° 34' 47"	
G34-6	-151146.002	-38745.737	4.574	100° 20' 22"	
G34-7	-151146.823	-38741.237	3.991	144° 12' 25"	
G34-8	-151150.060	-38738.903	12.760	188° 04' 07"	
G34-9	-151162.694	-38740.694	18.282	285° 56' 37"	
G34-43	-151157.672	-38758.273	0.426	289° 01' 48"	
G34-42	-151157.533	-38758.676	13.743	14° 30' 01"	

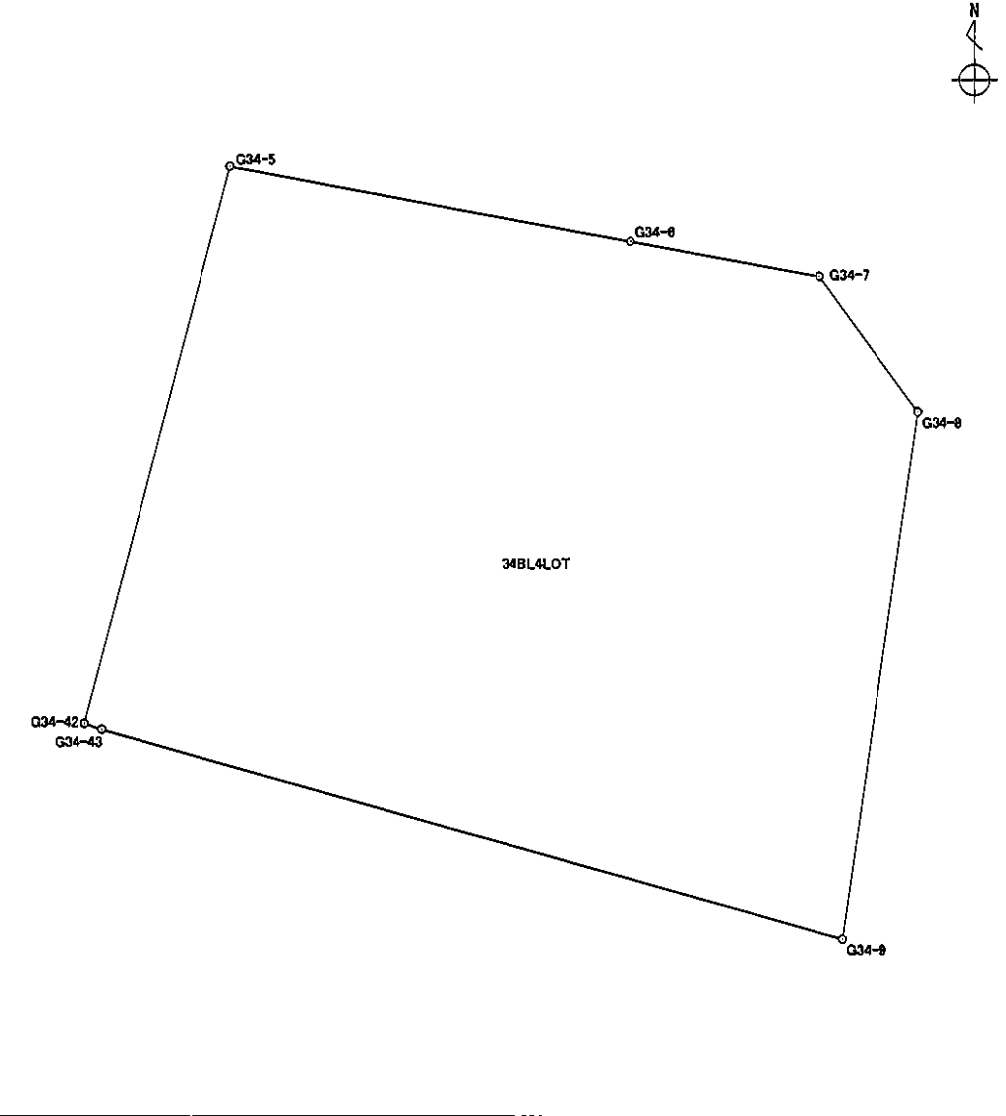

面積算公式 $A = \frac{1}{2} \sum X_n \times (Y_{n+1} - Y_{n-1})$	面積	256.6411900	土地の所在	
	地積	256.64	土地の所有者	

座標面積計算書

世界測地系


地番 34BL5LOT 地目

境界点	X座標	Y座標	辺長	方向角	備考			
G34-9	-151162.694	-38740.694	0.595	188° 01' 16"				
G34-10	-151163.283	-38740.777	7.316	286° 12' 28"				
G34-58	-151161.241	-38747.802	10.719	287° 50' 48"				
G34-44	-151157.956	-38758.005	0.390	316° 39' 37"				
G34-43	-151157.672	-38758.273	18.282	105° 56' 37"				
面積算出公式						面積	8.2392860	土地の所在
$A = \frac{1}{2} \sum X_n \times (Y_{n+1} - Y_{n-1})$						地積	8.23	土地の所有者

座 標 面 積 計 算 書

世界測地系


地番	34BL6LOT	地目	
----	----------	----	--

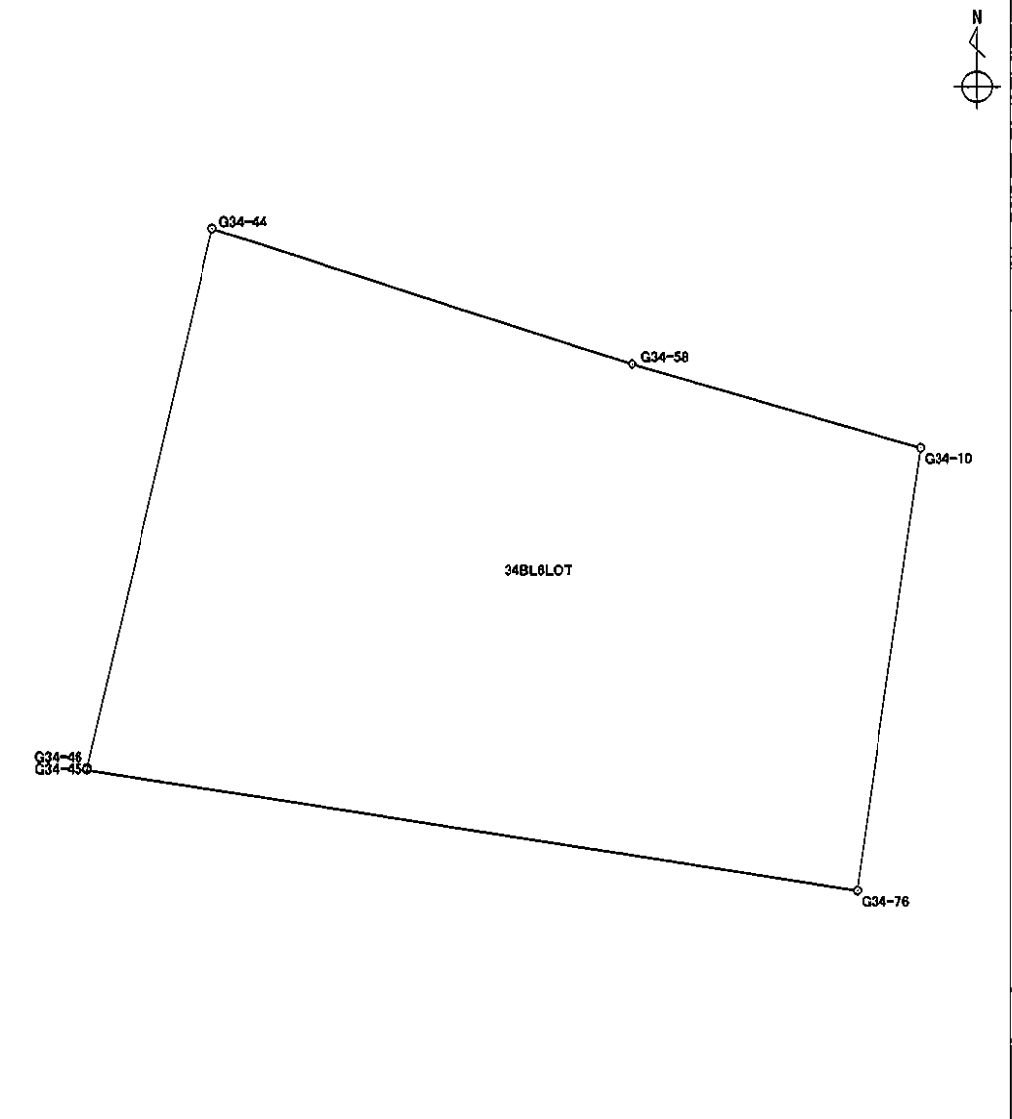境界点	X 座標	Y 座標	辺長	方向角	備考	
G34-10	-151163.283	-38740.777	10.949	188° 02' 37"		
G34-76	-151174.124	-38742.309	18.955	278° 51' 09"		
G34-45	-151171.207	-38761.038	0.046	12° 31' 44"		
G34-46	-151171.162	-38761.028	13.548	12° 53' 37"		
G34-44	-151157.956	-38758.005	10.719	107° 50' 48"		
G34-58	-151161.241	-38747.802	7.316	106° 12' 28"		
面積算出公式		面 積	224.8581640	土地の所在		
$A = \frac{1}{2} \sum X_n \times (Y_{n+1} - Y_{n-1})$		地 積	224.85	土地の所有者		

座標面積計算書

世界測地系


地番	34BL7LOT	地目	
----	----------	----	--

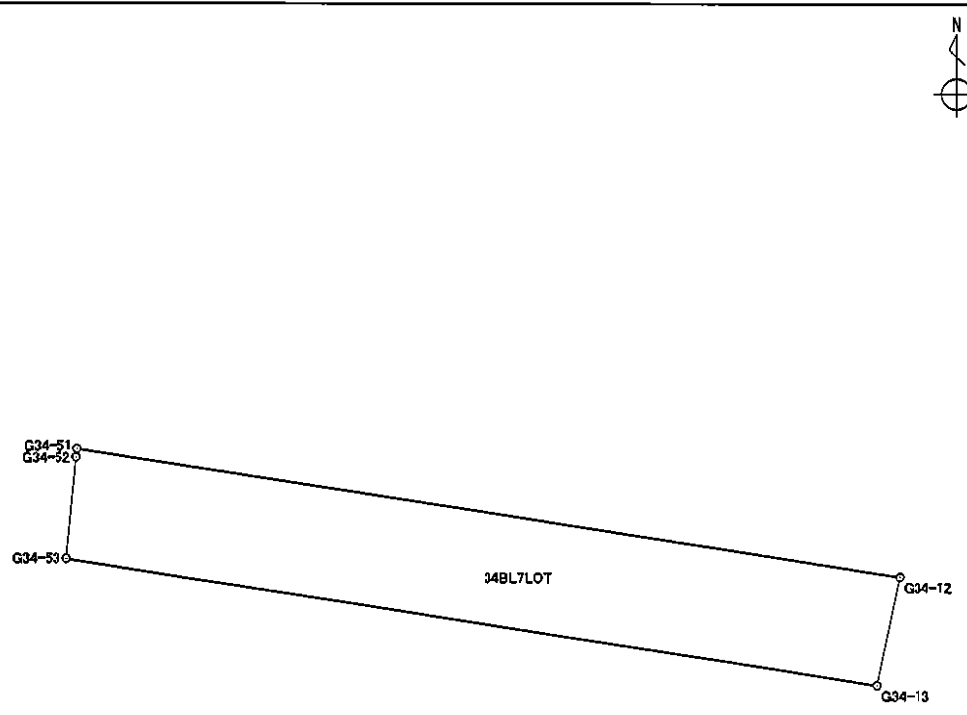境界点	X座標	Y座標	辺長	方向角	備考	
G34-12	-151189.863	-38745.066	2.533	191° 31' 22"		
G34-13	-151192.345	-38745.572	18.662	278° 52' 28"		
G34-53	-151189.466	-38764.011	2.345	5° 18' 34"		
G34-52	-151187.131	-38763.794	0.190	5° 26' 25"		
G34-51	-151186.942	-38763.776	18.937	98° 52' 24"		
面積算出公式		面積	47.5669320		土地の所在	
$A = \frac{1}{2} \sum X_n \times (Y_{n+1} - Y_{n-1})$		地積	47.56		土地の所有者	

座標面積計算書

地番	34BL8LOT	地目	
----	----------	----	--

境界点	X座標	Y座標	辺長	方向角	備考
G34-13	-151192.345	-38745.572	6.125	191° 34' 33"	
G34-14	-151198.345	-38746.801	4.852	192° 27' 39"	
G34-15	-151203.083	-38747.848	3.000	282° 54' 21"	
G34-59	-151202.413	-38750.772	15.495	282° 54' 38"	
G34-55	-151198.951	-38765.875	6.687	11° 01' 33"	
G34-54	-151192.387	-38764.596	2.979	11° 19' 30"	
G34-53	-151189.466	-38764.011	18.662	98° 52' 28"	

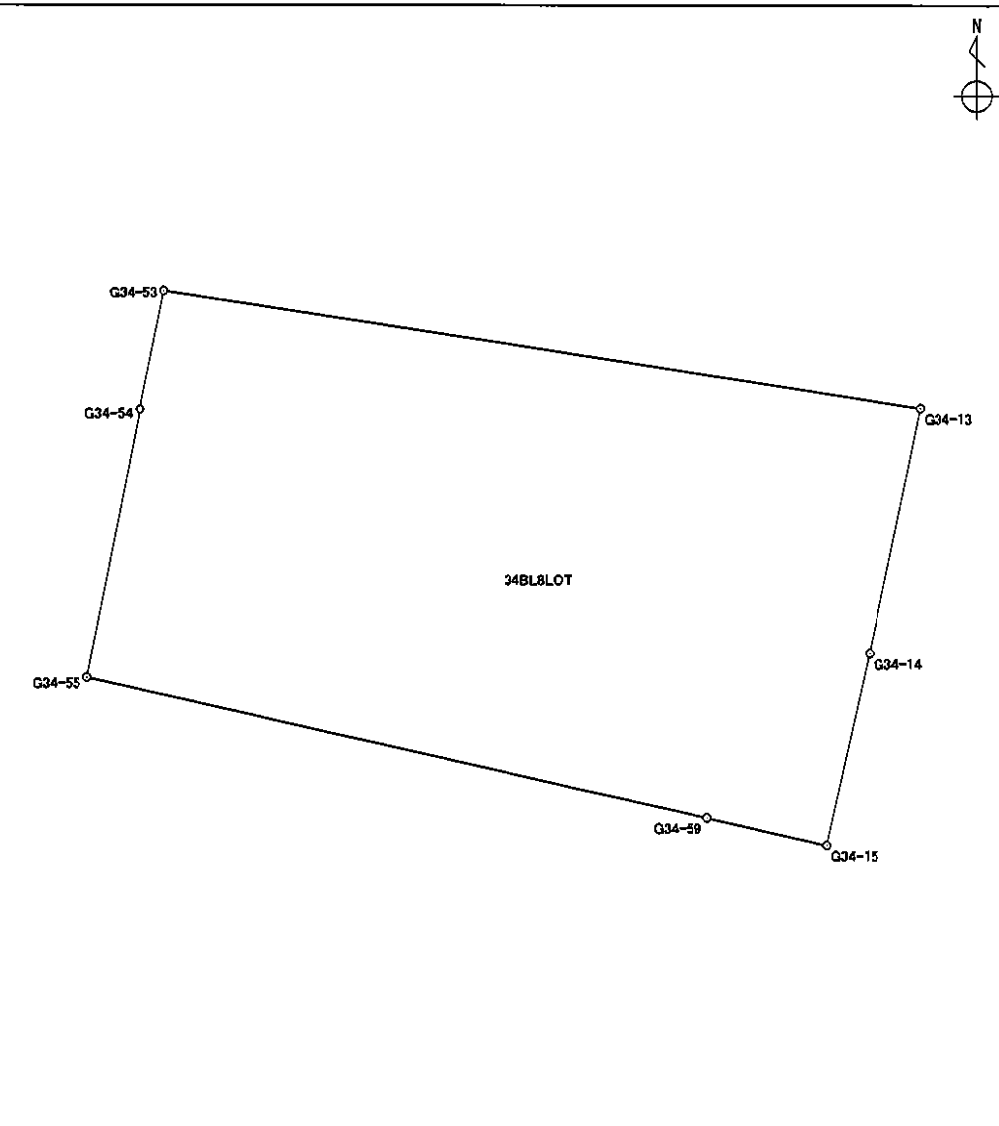


面積算出公式 $A = \frac{1}{2} \sum X_n \times (Y_{n+1} - Y_{n-1})$	面積	191.9027930	土地の所在	
	地積	191.90	土地の所有者	

座 標 面 積 計 算 書

世界測地系

地番	34BL9LOT	地目	
----	----------	----	--

境界点	X 座標	Y 座標	辺長	方向角	備考
G34-15	-151203.083	-38747.848	10.168	192° 24' 35"	
G34-16	-151213.013	-38750.033	3.988	237° 37' 01"	
G34-18	-151215.149	-38753.401	13.005	11° 39' 48"	
G34-59	-151202.413	-38750.772	3.000	102° 54' 21"	

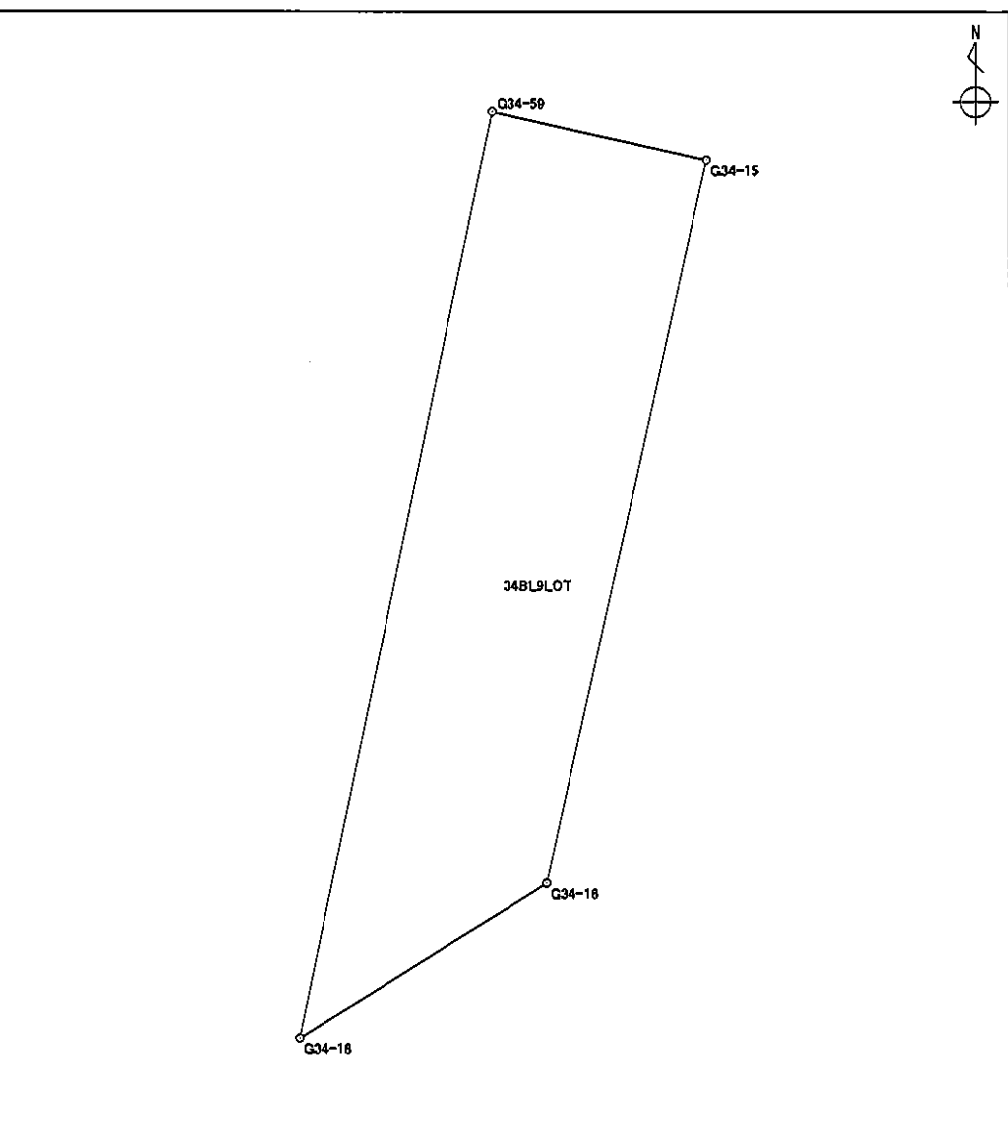


面積算出公式	面積	33.8892870	土地の所在	
$A = \frac{1}{2} \sum X_n \times (Y_{n+1} - Y_{n-1})$	地積	33.88	土地の所有者	

座標面積計算書

世界測地系

地番 34BL10LOT 地目

境界点	X座標	Y座標	辺長	方向角	備考
G34-18	-151215.149	-38753.401	15.339	282° 56' 40"	
G34-19	-151211.713	-38768.350	7.205	10° 56' 14"	
G34-56	-151204.639	-38766.983	5.795	11° 01' 23"	
G34-55	-151198.951	-38765.875	15.495	102° 54' 38"	
G34-59	-151202.413	-38750.772	13.005	191° 39' 48"	

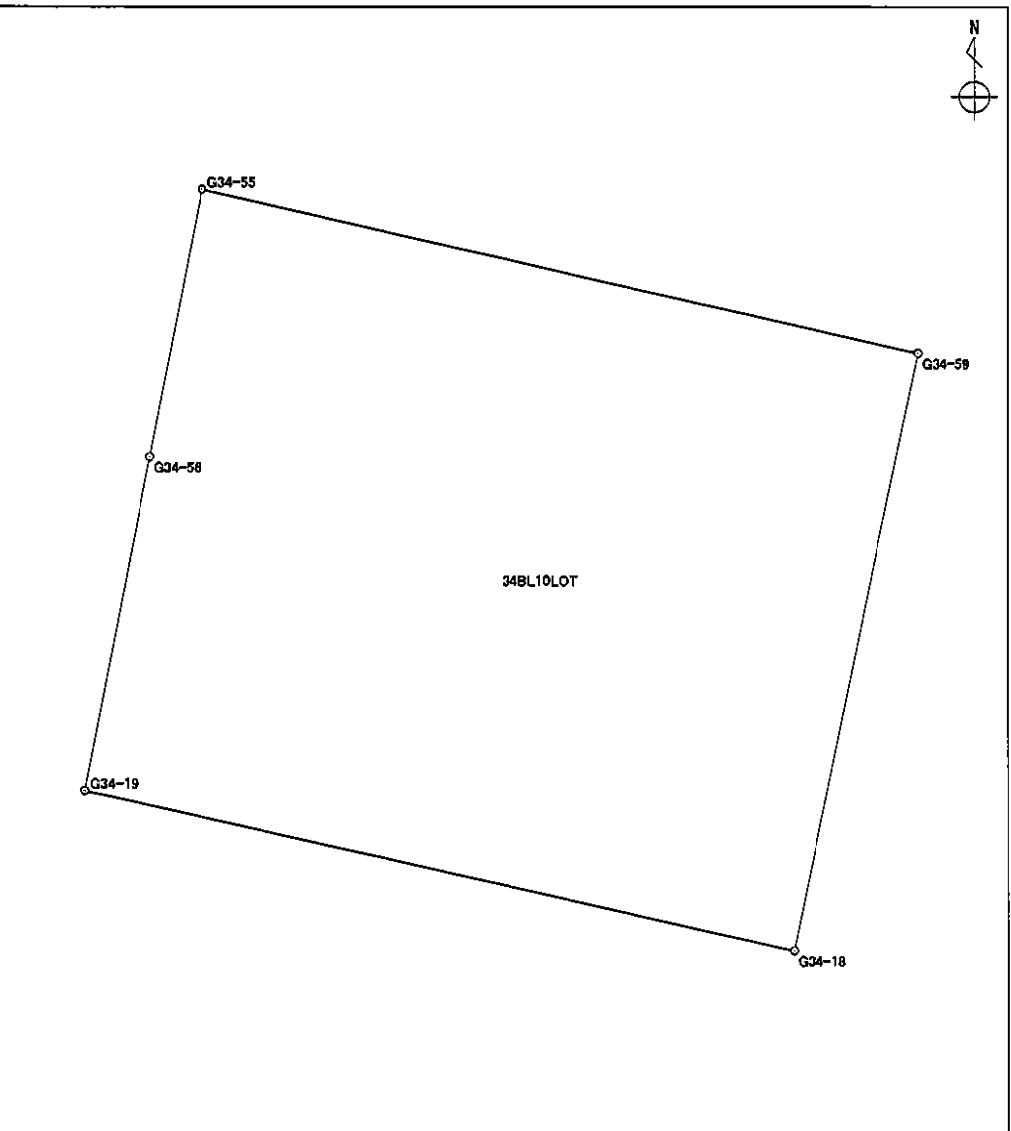


面積算出公式 $A = \frac{1}{2} \sum X_n \times (Y_{n+1} - Y_{n-1})$	面積	200.3995700	土地の所在	
	地積	200.39	土地の所有者	

座 標 面 積 計 算 書

世界測地系

地番 34BL11LOT 地目

境界点	X 座標	Y 座標	辺長	方向角	備考
G34-19	-151211.713	-38768.350	14.930	282° 56' 50"	
K37	-151208.368	-38782.900	1.177	286° 20' 24"	
K38	-151208.037	-38784.029	0.649	284° 33' 01"	
G34-21	-151207.874	-38784.657	6.722	11° 46' 35"	
G34-73	-151201.293	-38783.285	4.892	101° 23' 17"	
G34-62	-151202.259	-38778.489	4.687	101° 23' 38"	
G34-63	-151203.185	-38773.894	7.062	101° 52' 52"	
G34-56	-151204.639	-38766.983	7.205	190° 56' 14"	

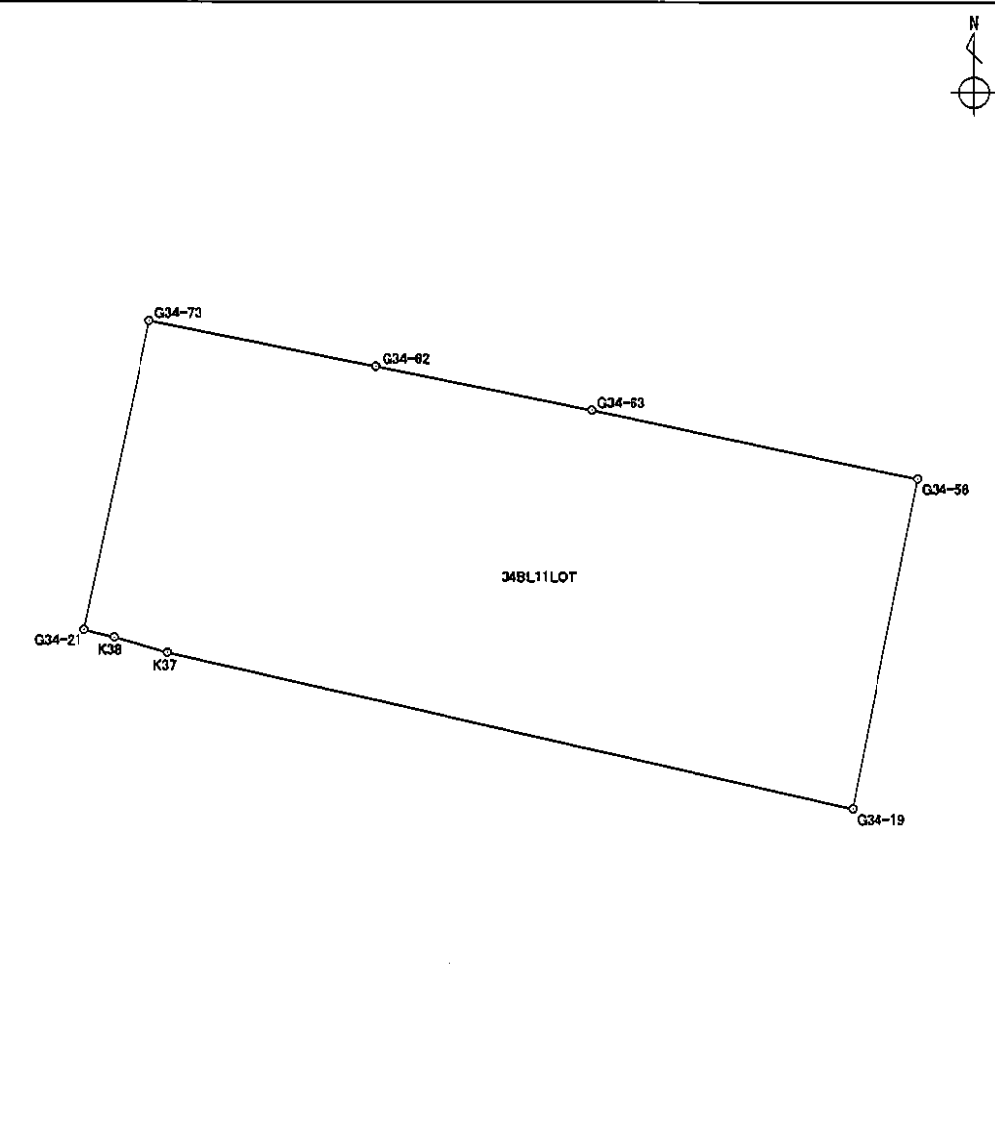


<p>面積算出公式 $A = \frac{1}{2} \sum X_n \times (Y_{n+1} - Y_{n-1})$</p>	面積	117.1728635	土地の所在	
	地積	117.17	土地の所有者	

座 標 面 積 計 算 書

世界測地系

地番	34BL13LOT	地目
----	-----------	----


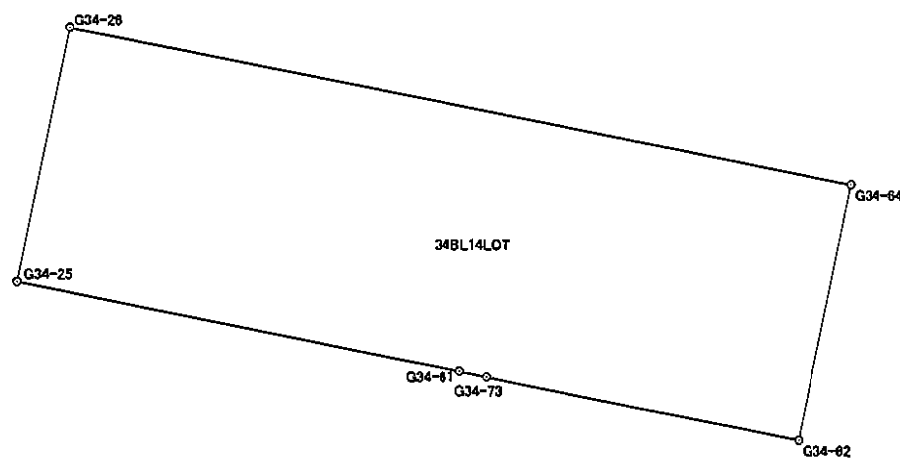
境界点	X 座標	Y 座標	辺長	方向角	備考
G34-22	-151207.779	-38785.024	1.118	284° 33' 30"	
K39	-151207.498	-38786.106	3.150	286° 52' 12"	
G34-23	-151206.584	-38789.120	3.974	329° 26' 04"	
G34-24	-151203.162	-38791.141	3.397	11° 20' 23"	
G34-25	-151199.831	-38790.473	6.912	101° 27' 28"	
G34-61	-151201.204	-38783.699	6.707	191° 23' 37"	

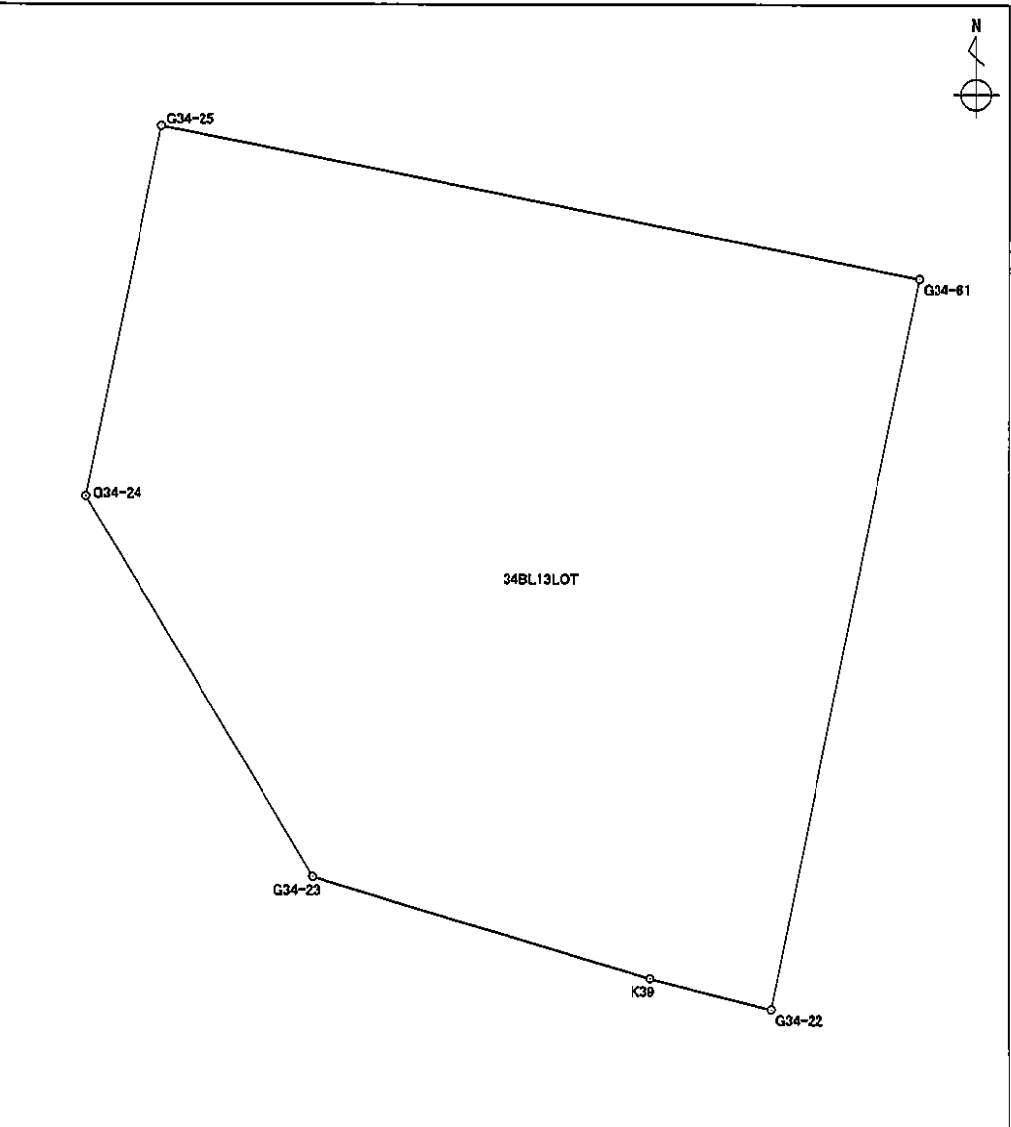

面積算出公式	面積	40.7807945	土地の所在	
$A = \frac{1}{2} \sum X_n \times (Y_{n+1} - Y_{n-1})$	地積	40.78	土地の所有者	

座標面積計算書

地番	34BL14LOT	地目	
----	-----------	----	--


境界点	X座標	Y座標	辺長	方向角	備考	
G34-25	-151199.831	-38790.473	4.000	11° 23' 29"		<div style="float: right; margin-bottom: 20px;">  </div> 
G34-26	-151195.910	-38789.683	12.228	101° 22' 50"		
G34-64	-151198.323	-38777.695	4.015	191° 24' 18"		
G34-62	-151202.259	-38778.489	4.892	281° 23' 17"		
G34-73	-151201.293	-38783.285	0.423	282° 07' 57"		
G34-61	-151201.204	-38783.699	6.912	281° 27' 28"		
面積算出公式		面積	49.0208770		土地の所在	
$A = \frac{1}{2} \sum X_n \times (Y_{n+1} - Y_{n-1})$			地積	49.02		土地の所有者

座標面積計算書

世界測地系

地番 34BL15LOT	地目
--------------	----

境界点	X 座標	Y 座標	辺長	方向角	備考
G34-26	-151195.910	-38789.683	8.406	11° 22' 56"	
G34-27	-151187.669	-38788.024	15.202	101° 46' 14"	
G34-70	-151190.770	-38773.142	8.698	100° 42' 52"	
G34-54	-151192.387	-38764.596	6.687	191° 01' 33"	
G34-55	-151198.951	-38765.875	5.795	191° 01' 23"	
G34-56	-151204.639	-38766.983	7.062	281° 52' 52"	
G34-63	-151203.185	-38773.894	4.687	281° 23' 38"	
G34-62	-151202.259	-38778.489	4.015	11° 24' 18"	
G34-64	-151198.323	-38777.695	12.228	281° 22' 50"	

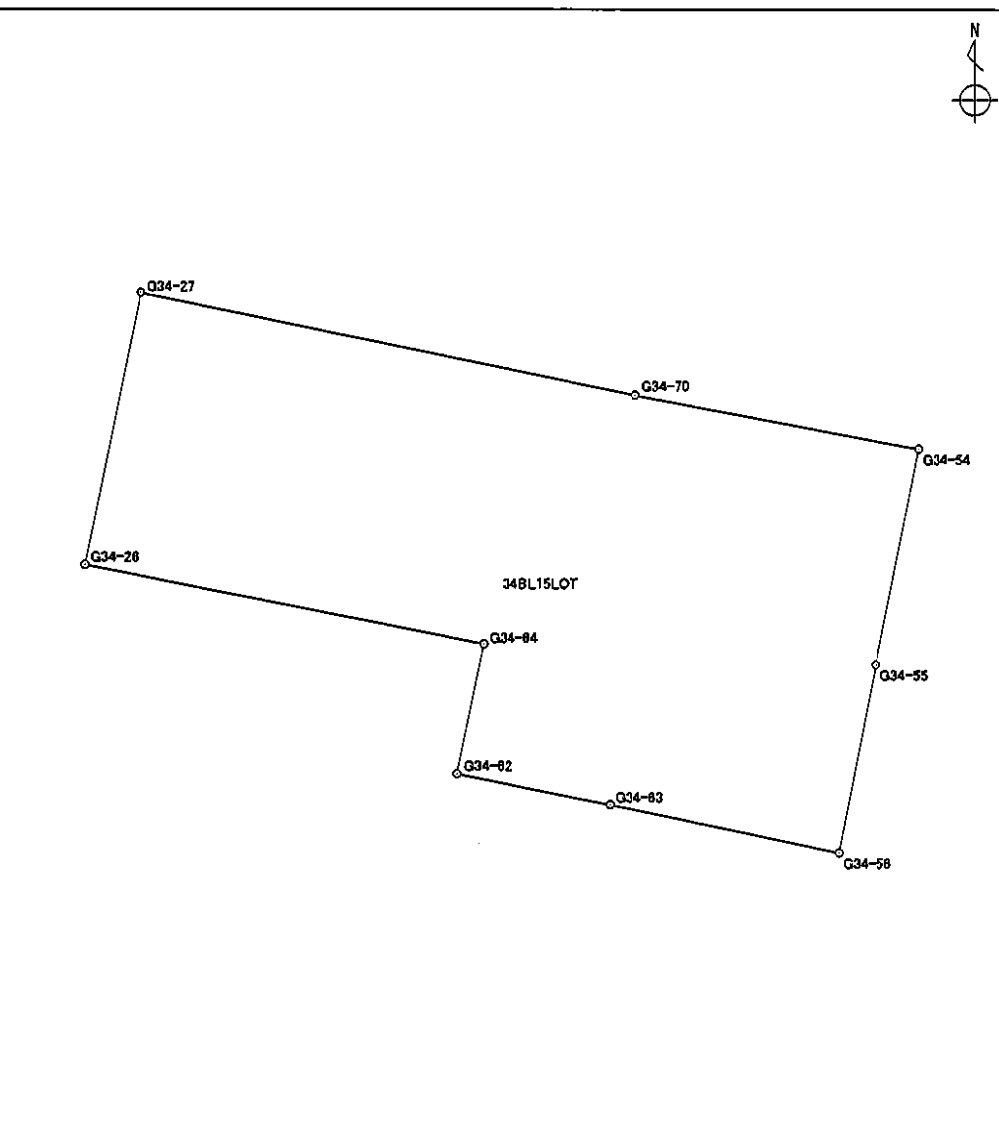


面積算出公式 $A = \frac{1}{2} \sum X_n \times (Y_{n+1} - Y_{n-1})$	面積	247.2212405	土地の所在	
	地積	247.22	土地の所有者	

座標面積計算書

世界測地系

地番 34BL16LOT 地目

境界点	X座標	Y座標	辺長	方向角	備考
G34-27	-151187.669	-38788.024	5.346	11° 28' 11"	
G34-28	-151182.430	-38786.961	4.502	100° 18' 05"	
G34-66	-151183.235	-38782.532	6.640	11° 28' 02"	
G34-65	-151176.728	-38781.212	16.414	100° 16' 19"	
G34-67	-151179.655	-38765.061	1.181	143° 42' 44"	
G34-68	-151180.607	-38764.362	8.713	186° 43' 22"	
G34-69	-151189.260	-38765.382	1.386	98° 32' 42"	
G34-53	-151189.466	-38764.011	2.979	191° 19' 30"	
G34-54	-151192.387	-38764.596	8.698	280° 42' 52"	
G34-70	-151190.770	-38773.142	15.202	281° 46' 14"	

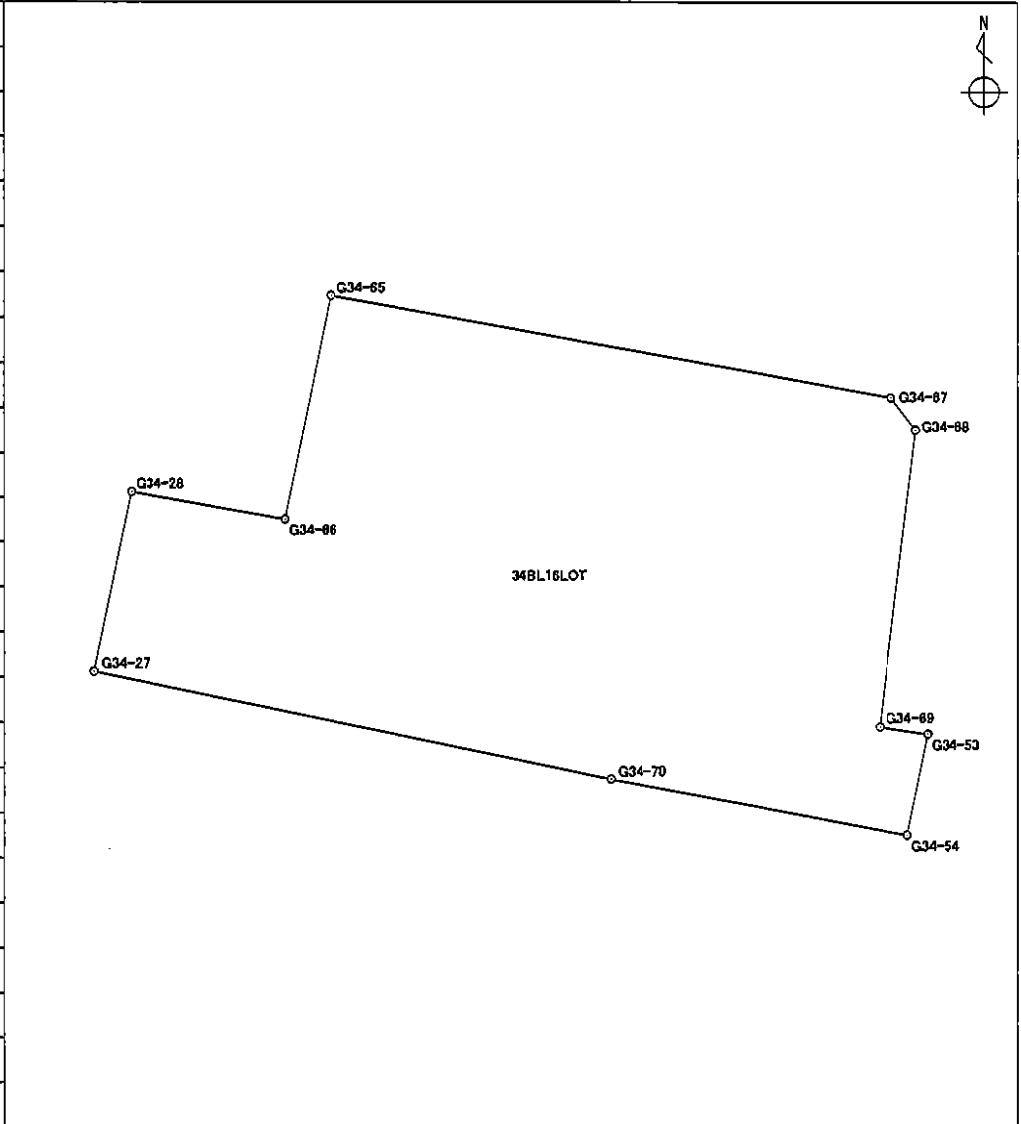


面積算出公式 $A = \frac{1}{2} \sum X_n \times (Y_{n+1} - Y_{n-1})$	面積	245.9711330	土地の所在	
	地積	245.97	土地の所有者	

座標面積計算書

世界測地系

地番 34BL17LOT	地目
--------------	----


境界点	X座標	Y座標	辺長	方向角	備考				
G34-28	-151182.430	-38786.961	6.638	11° 28' 15"					
G34-29	-151175.925	-38785.641	4.501	100° 16' 35"					
G34-65	-151176.728	-38781.212	6.640	191° 28' 02"					
G34-66	-151183.235	-38782.532	4.502	280° 18' 05"					
<div style="display: flex; justify-content: space-between; align-items: center;"> <div style="width: 45%;"> <p>面積算出公式</p> $A = \frac{1}{2} \sum X_n \times (Y_{n+1} - Y_{n-1})$ </div> <div style="width: 45%; border-left: 1px solid black; padding-left: 10px;"> <table border="0" style="width: 100%;"> <tr> <td style="border-right: 1px solid black; padding-right: 5px;">面積</td> <td style="text-align: right;">29.8763540</td> </tr> <tr> <td style="border-right: 1px solid black; padding-right: 5px;">地積</td> <td style="text-align: right;">29.87</td> </tr> </table> </div> <div style="width: 45%;"> <p>土地の所在</p> <hr/> <p>土地の所有者</p> </div> </div>						面積	29.8763540	地積	29.87
面積	29.8763540								
地積	29.87								

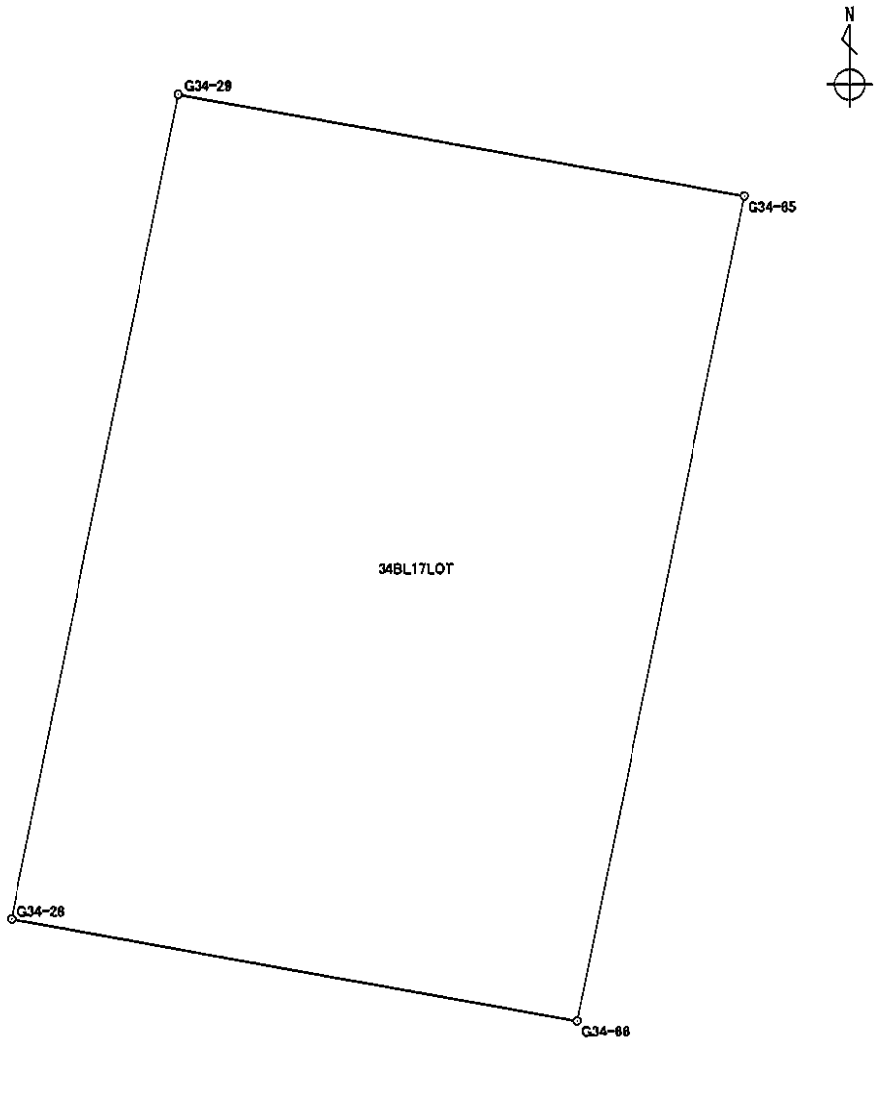

座標面積計算書

地番 34BL18LOT 地目

境界点	X座標	Y座標	辺長	方向角	備考
G34-29	-151175.925	-38785.641	1.150	11° 23' 17"	
G34-72	-151174.798	-38785.414	22.964	100° 16' 19"	
G34-49	-151178.893	-38762.818	1.461	193° 03' 23"	
G34-50	-151180.316	-38763.148	6.656	185° 24' 51"	
G34-51	-151186.942	-38763.776	0.190	185° 26' 25"	
G34-52	-151187.131	-38763.794	2.345	185° 18' 34"	
G34-53	-151189.466	-38764.011	1.386	278° 32' 42"	
G34-69	-151189.260	-38765.382	8.713	6° 43' 22"	
G34-68	-151180.607	-38764.362	1.181	323° 42' 44"	
G34-67	-151179.655	-38765.061	16.414	280° 16' 19"	
G34-65	-151176.728	-38781.212	4.501	280° 16' 35"	

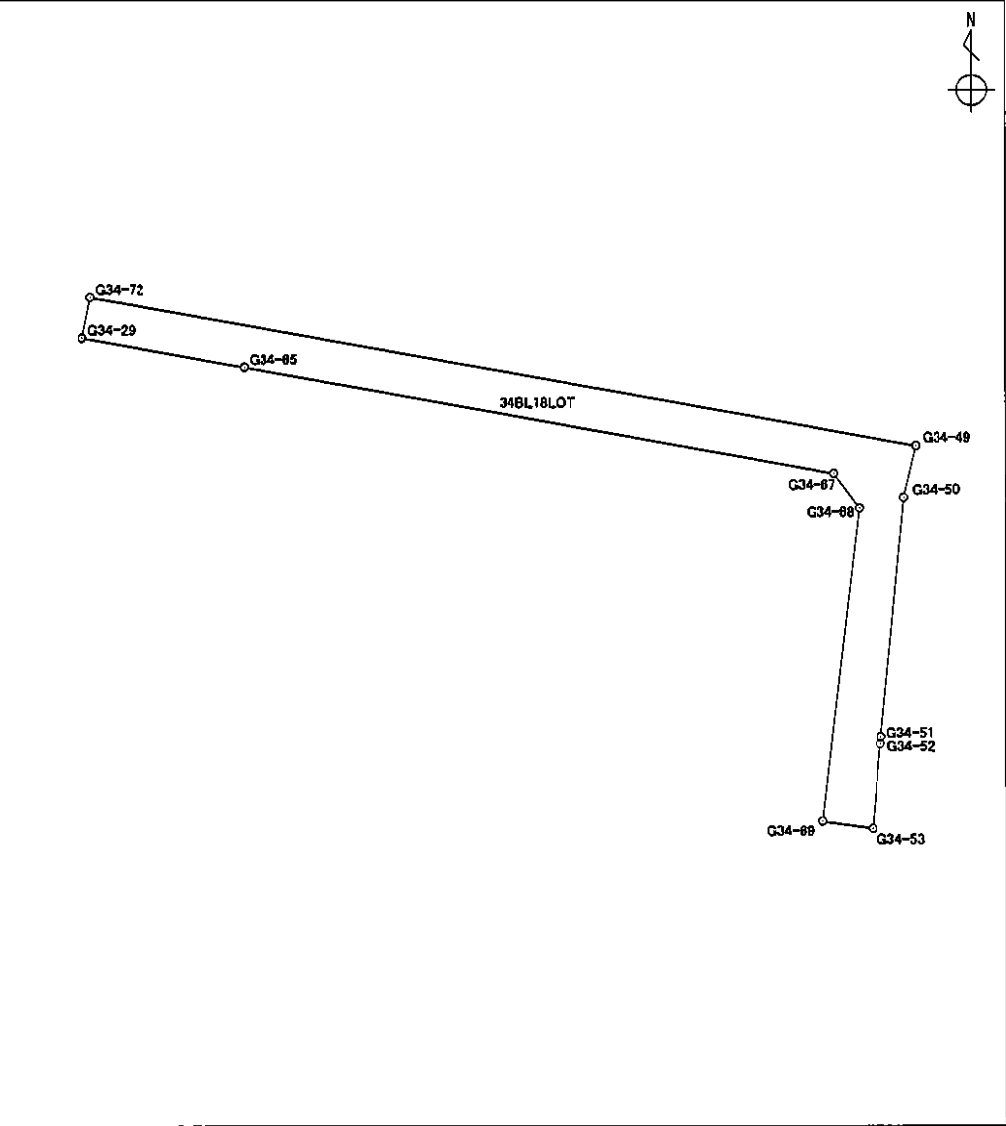

面積算出公式 $A = \frac{1}{2} \sum X_n \times (Y_{n+1} - Y_{n-1})$	面積	38.8250070	土地の所在	
	地積	38.82	土地の所有者	

座 標 面 積 計 算 書

世界測地系

地番	34BL19LOT	地目	
----	-----------	----	--

境 界 点	X 座 標	Y 座 標	辺 長	方 向 角	備 考	
G34-72	-151174.798	-38785.414	3.106	11° 24' 01"		
G34-30	-151171.753	-38784.800	23.053	100° 16' 21"		
G34-48	-151175.864	-38762.117	3.109	193° 01' 50"		
G34-49	-151178.893	-38762.818	22.964	280° 16' 19"		

面積算出公式	面 積	71.4538840	土地の所在	
$A = \frac{1}{2} \sum X_n \times (Y_{n+1} - Y_{n-1})$	地 積	71.45	土地の所有者	

座 標 面 積 計 算 書

世界測地系

地番	34BL20LOT	地目	
----	-----------	----	--


境界点	X 座標	Y 座標	辺長	方向角	備考	
G34-30	-151171.753	-38784.800	0.811	11° 22' 45"		
G34-31	-151170.958	-38784.640	23.075	100° 18' 19"		
G34-47	-151175.086	-38761.937	0.799	193° 01' 37"		
G34-48	-151175.864	-38762.117	23.053	280° 16' 21"		
面積算出公式			面積	18.5483595	土地の所在	
$A = \frac{1}{2} \sum X_n \times (Y_{n+1} - Y_{n-1})$			地積	18.54	土地の所有者	

座標面積計算書

世界測地系

地番	34BL21LOT	地目	
----	-----------	----	--

境界点	X座標	Y座標	辺長	方向角	備考
G34-31	-151170.958	-38784.640	3.951	11° 11' 36"	
G34-33	-151167.082	-38783.873	0.060	11° 29' 48"	
G34-34	-151167.023	-38783.861	23.205	100° 16' 29"	
G34-46	-151171.162	-38761.028	0.046	192° 31' 44"	
G34-45	-151171.207	-38761.038	3.982	193° 02' 55"	
G34-47	-151175.086	-38761.937	23.075	280° 18' 19"	

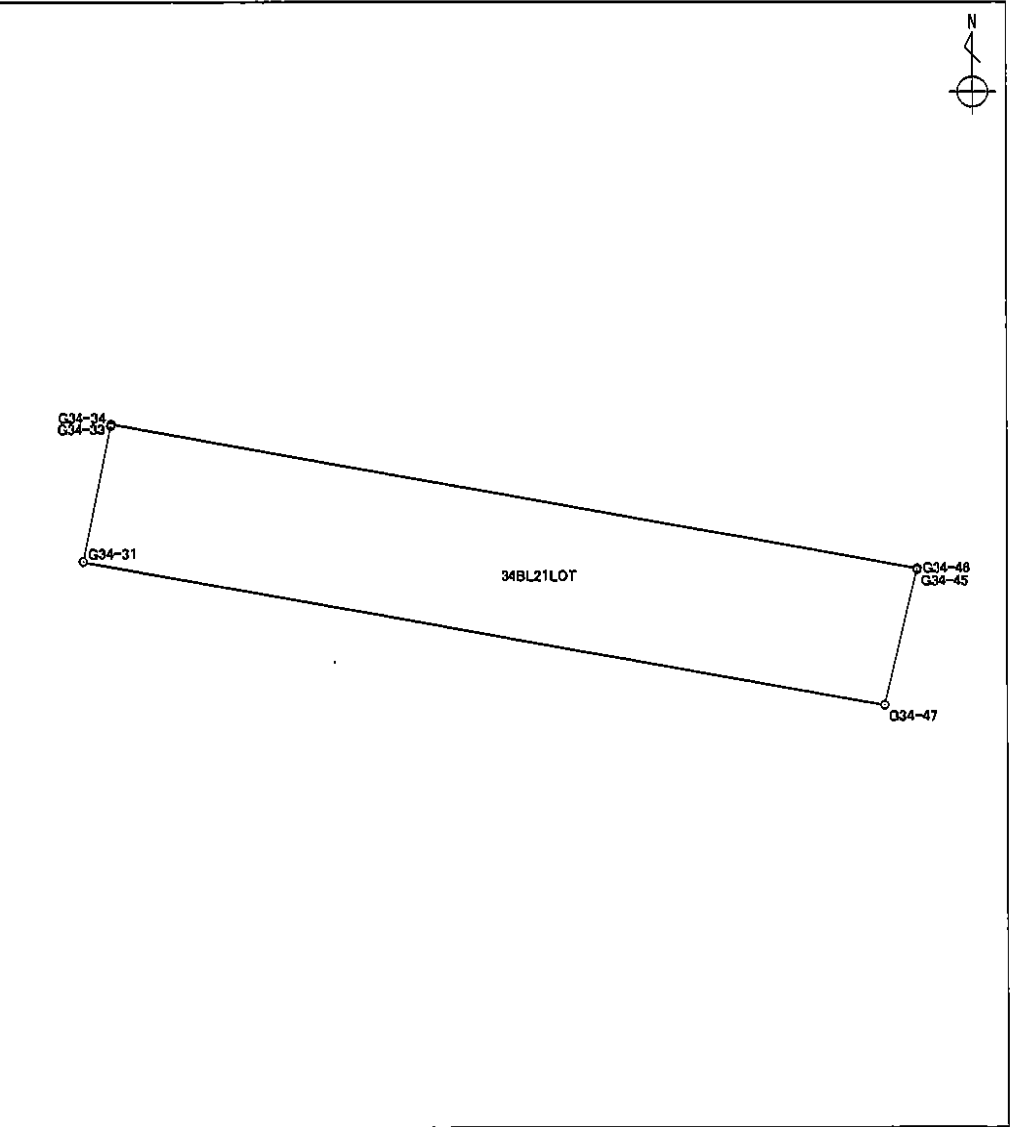


面積算出公式 $A = \frac{1}{2} \sum X_n \times (Y_{n+1} - Y_{n-1})$	面積	92.9569920	土地の所在
	地積	92.95	土地の所有者

座 標 面 積 計 算 書

世界測地系

地番 34BL22LOT 地目

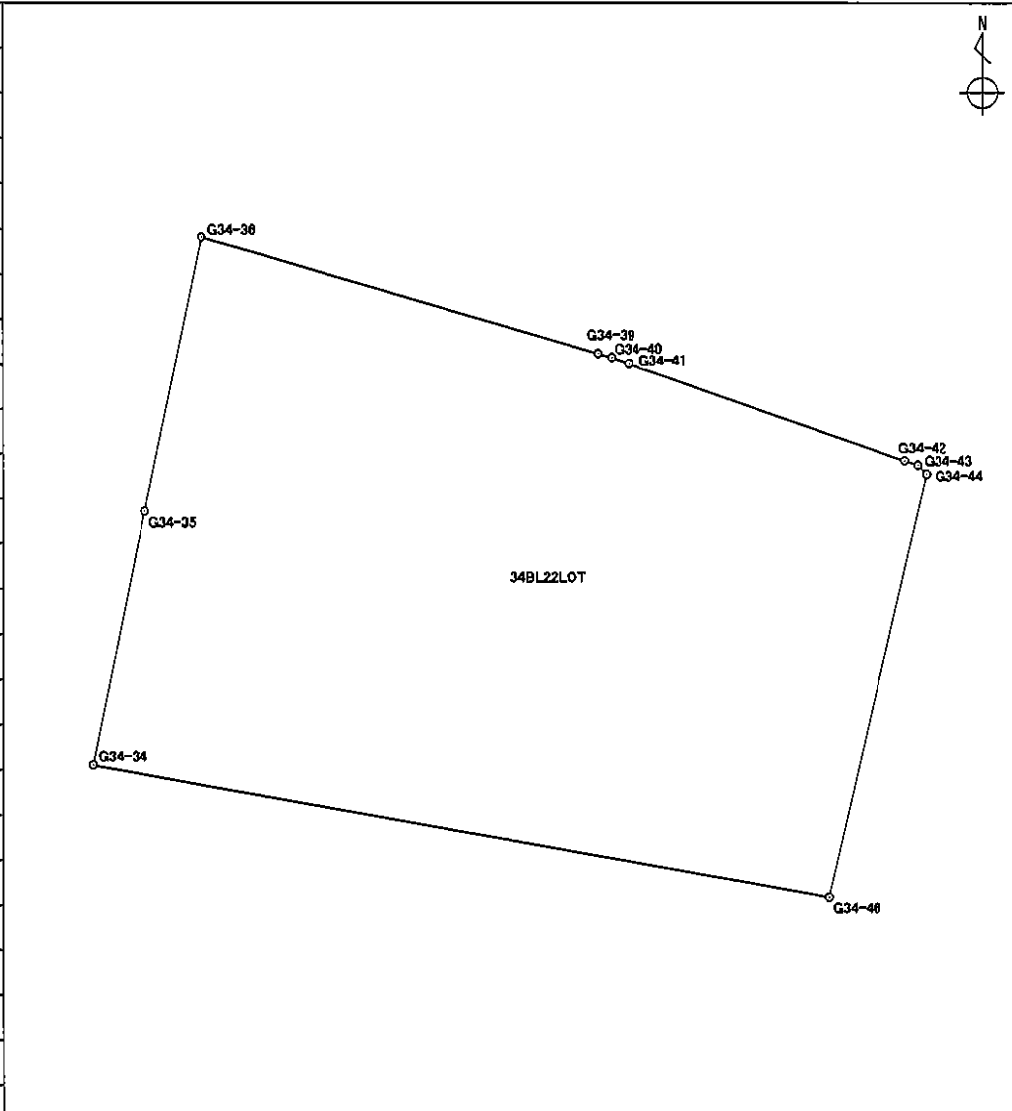
境界点	X 座標	Y 座標	辺長	方向角	備考	
G34-34	-151167.023	-38783.861	8.054	11° 20' 31"		
G34-35	-151159.126	-38782.277	8.805	11° 37' 49"		
G34-36	-151150.502	-38780.502	12.831	106° 31' 01"		
G34-39	-151154.150	-38768.200	0.438	106° 41' 57"		
G34-40	-151154.276	-38767.780	0.558	109° 42' 08"		
G34-41	-151154.464	-38767.255	9.111	109° 41' 02"		
G34-42	-151157.533	-38758.676	0.426	109° 01' 48"		
G34-43	-151157.672	-38758.273	0.390	136° 39' 37"		
G34-44	-151157.956	-38758.005	13.548	192° 53' 37"		
G34-46	-151171.162	-38761.028	23.205	280° 16' 29"		

面積算出公式	面積	361.3987985	土地の所在	
$A = \frac{1}{2} \sum X_n \times (Y_{n+1} - Y_{n-1})$	地積	361.39	土地の所有者	

座 標 面 積 計 算 書

世界測地系

地番 34BL23LOT 地目

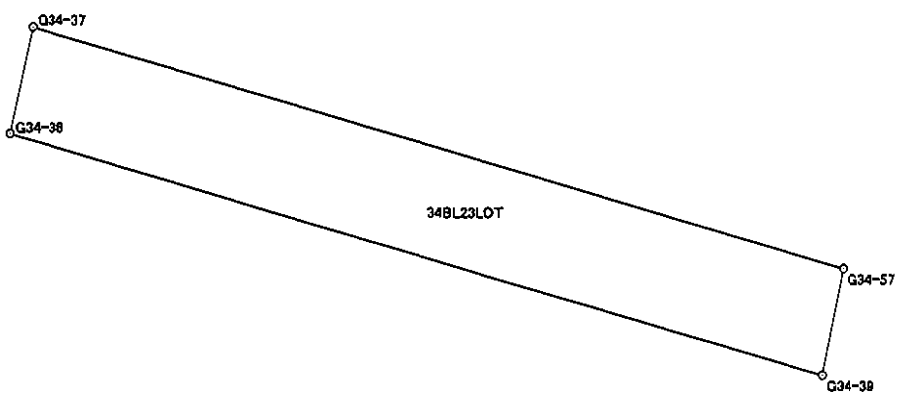
境界点	X 座標	Y 座標	辺長	方向角	備考		
G34-36	-151150.502	-38780.502	1.657	11° 48' 18"			
G34-37	-151148.880	-38780.163	12.802	106° 29' 44"			
G34-57	-151152.515	-38767.888	1.665	190° 48' 13"			
G34-39	-151154.150	-38768.200	12.831	286° 31' 01"			
面積算出公式		面積	21.1971305		土地の所在		
$A = \frac{1}{2} \sum X_n \times (Y_{n+1} - Y_{n-1})$		地積	21.19		土地の所有者		

座標面積計算書

世界測地系

地番 34BL24LOT 地目

境界点	X 座標	Y 座標	辺長	方向角	備考
G34-21	-151207.874	-38784.657	0.379	284° 30' 46"	
G34-22	-151207.779	-38785.024	6.707	11° 23' 37"	
G34-61	-151201.204	-38783.699	0.423	102° 07' 57"	
G34-73	-151201.293	-38783.285	6.722	191° 46' 35"	

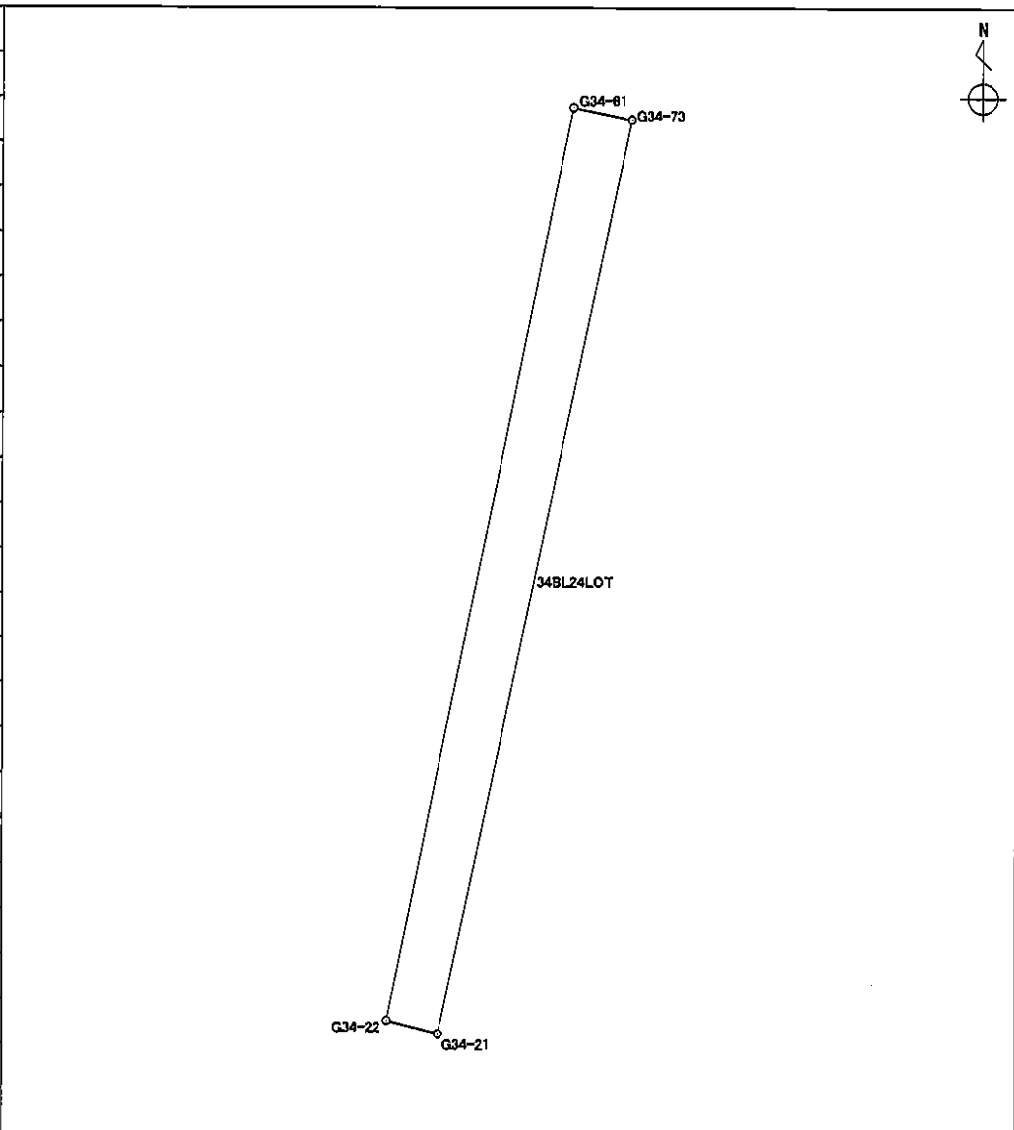


面積算出公式		面積	2.6927710	土地の所在	
$A = \frac{1}{2} \sum X_n \times (Y_{n+1} - Y_{n-1})$		地積	2.69	土地の所有者	

座 標 面 積 計 算 書

世界測地系

地番 34BL25LOT 地目

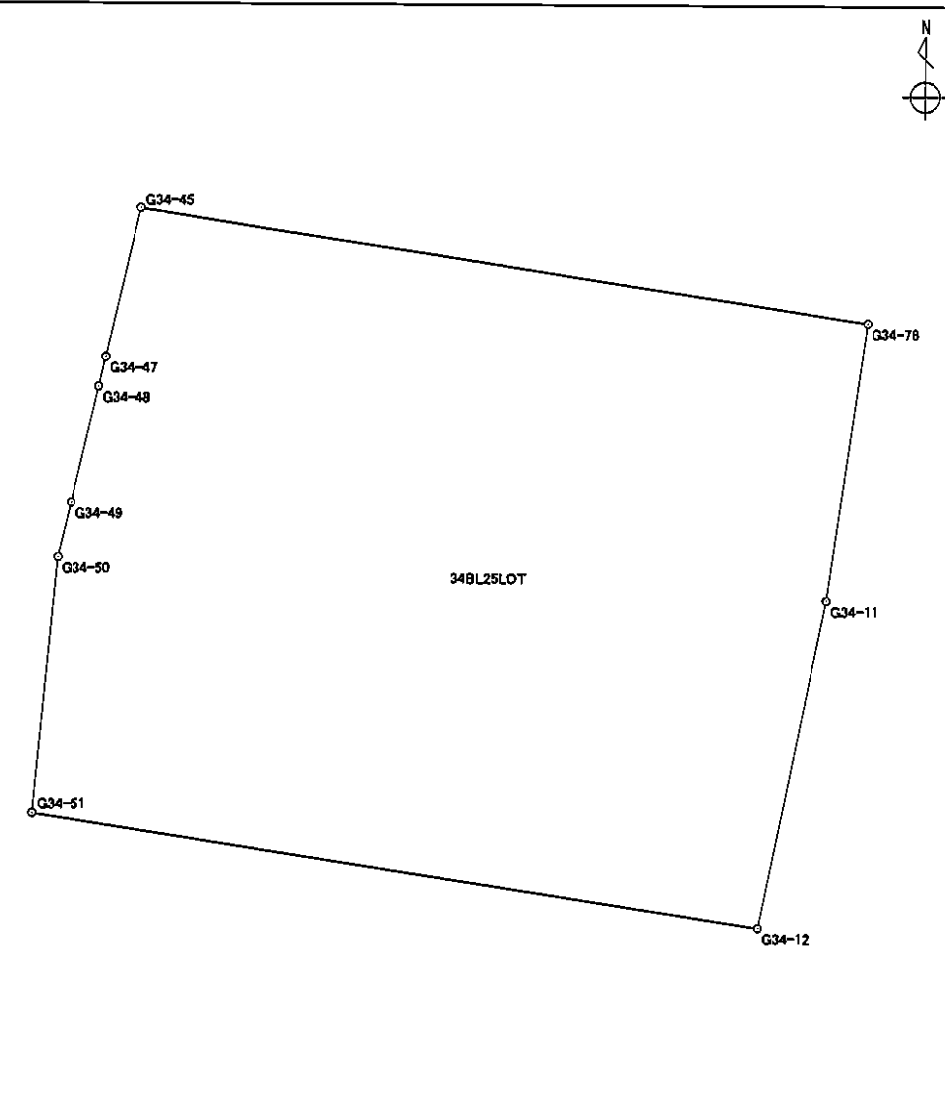境界点	X 座標	Y 座標	辺長	方向角	備考	
G34-76	-151174.124	-38742.309	7.302	188° 02' 45"		
G34-11	-151181.354	-38743.331	8.684	191° 31' 29"		
G34-12	-151189.863	-38745.066	18.937	278° 52' 24"		
G34-51	-151186.942	-38763.776	6.656	5° 24' 51"		
G34-50	-151180.316	-38763.148	1.461	13° 03' 23"		
G34-49	-151178.893	-38762.818	3.109	13° 01' 50"		
G34-48	-151175.864	-38762.117	0.799	13° 01' 37"		
G34-47	-151175.086	-38761.937	3.982	13° 02' 55"		
G34-45	-151171.207	-38761.038	18.955	98° 51' 09"		
面積算出公式		面積	308.6636020		土地の所在	
$A = \frac{1}{2} \sum X_n \times (Y_{n+1} - Y_{n-1})$			地積	308.66		土地の所有者