

面積集計表

平成 19 年 10 月 5 日


現場名: 平成18年度出来形確認測量

| 所有者 | No. | 地番No | 地番名 | 面積 | 地積 | 坪数 |
|-----|-----|------|-----------|--------------|---------|--------|
| | 1 | 531 | 31BL1LOT | 484.2904775 | 484.29 | 146.49 |
| | 2 | 532 | 31BL2LOT | 432.1125095 | 432.11 | 130.71 |
| | 3 | 533 | 31BL4LOT | 132.8353440 | 132.83 | 40.18 |
| | 4 | 534 | 31BL5LOT | 38.3460380 | 38.34 | 11.59 |
| | 5 | 535 | 31BL6LOT | 52.4534760 | 52.45 | 15.86 |
| | 6 | 536 | 31BL7LOT | 335.9041260 | 335.90 | 101.61 |
| | 7 | 537 | 31BL8LOT | 154.8695850 | 154.86 | 46.84 |
| | 8 | 538 | 31BL9LOT | 56.5660295 | 56.56 | 17.11 |
| | 9 | 539 | 31BL10LOT | 656.8048235 | 656.80 | 198.68 |
| | 10 | 540 | 31BL11LOT | 46.5521890 | 46.55 | 14.08 |
| | 11 | 541 | 31BL12LOT | 46.9392490 | 46.93 | 14.19 |
| | 12 | 542 | 31BL13LOT | 24.8205365 | 24.82 | 7.50 |
| | 13 | 543 | 31BL14LOT | 93.8457110 | 93.84 | 28.38 |
| | 14 | 58 | 31BL水路 | 80.3338520 | 80.33 | 24.30 |
| 合計 | | | 14筆 | 2636.6739465 | 2636.61 | 797.52 |

座 標 面 積 計 算 書

地番 31BL1LOT 地目

| 境界点 | X 座標 | Y 座標 | 辺長 | 方向角 | 備考 |
|--------|-------------|------------|--------|--------------|----|
| G31-1 | -151116.030 | -38921.126 | 4.011 | 55° 30' 49" | |
| G31-2 | -151113.759 | -38917.820 | 19.300 | 100° 41' 13" | |
| G31-3 | -151117.338 | -38898.855 | 22.103 | 190° 48' 51" | |
| G31-25 | -151139.048 | -38903.002 | 22.103 | 280° 47' 34" | |
| G31-16 | -151134.909 | -38924.714 | 19.217 | 10° 45' 39" | |
| | | | | | |
| | | | | | |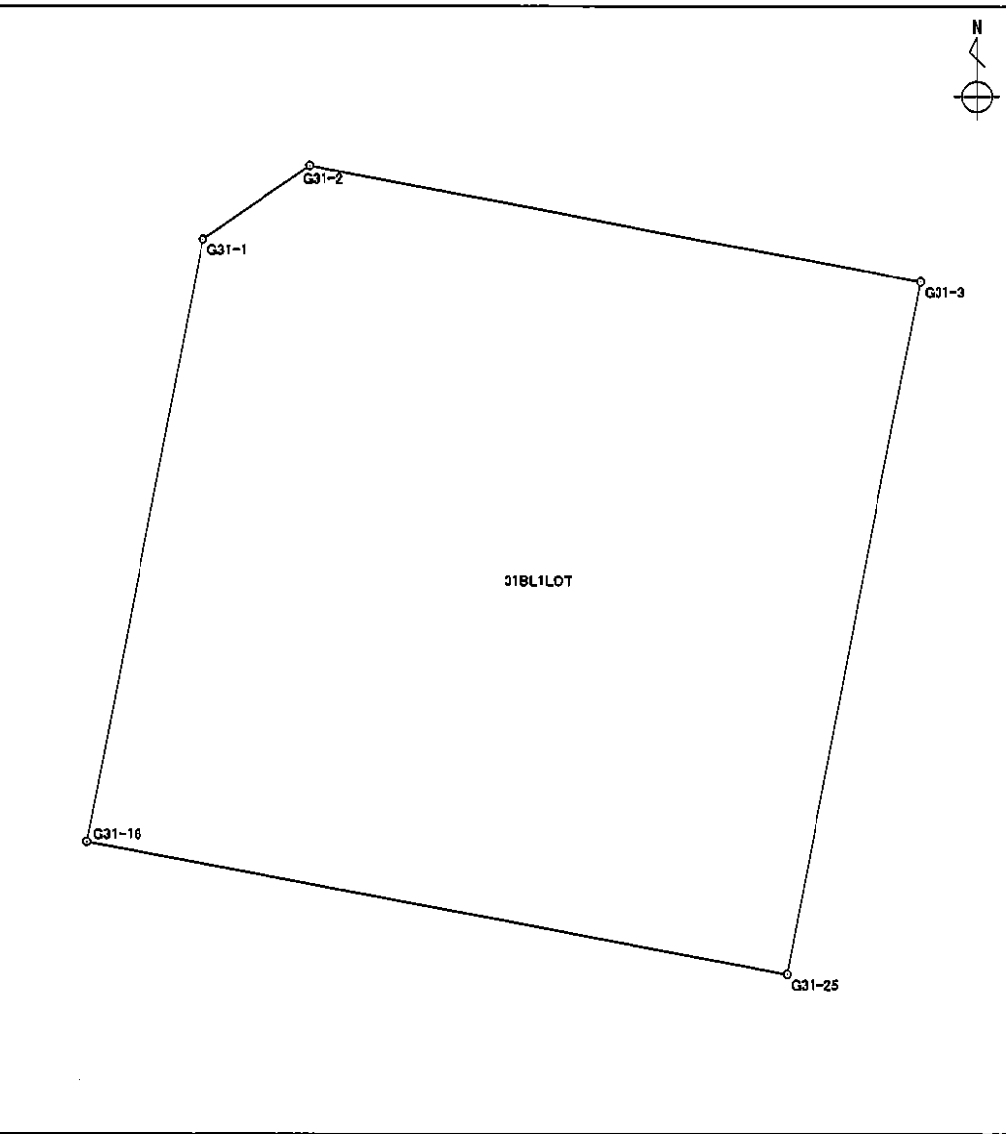
| | | | | |
|-------------------------------------------------------|-----|-------------|--------|--|
| 面積算出公式 | 面 積 | 484.2904775 | 土地の所在 | |
| $A = \frac{1}{2} \sum X_n \times (Y_{n+1} - Y_{n-1})$ | 地 積 | 484.29 | 土地の所有者 | |

座標面積計算書

世界測地系

| | | | |
|----|----------|----|--|
| 地番 | 31BL2LOT | 地目 | |
|----|----------|----|--|

| 境界点 | X 座標 | Y 座標 | 辺長 | 方向角 | 備考 |
|--------|-------------|------------|--------|--------------|----|
| G31-3 | -151117.338 | -38898.855 | 15.374 | 100° 36' 40" | |
| G31-4 | -151120.169 | -38883.744 | 2.039 | 143° 56' 22" | |
| G31-5 | -151121.817 | -38882.544 | 2.301 | 187° 08' 26" | |
| G31-17 | -151124.100 | -38882.830 | 21.120 | 187° 26' 36" | |
| G31-18 | -151145.042 | -38885.566 | 18.251 | 280° 59' 32" | |
| G31-26 | -151141.562 | -38903.482 | 2.559 | 10° 48' 34" | |
| G31-25 | -151139.048 | -38903.002 | 22.103 | 10° 48' 51" | |
| | | | | | |
| | | | | | |
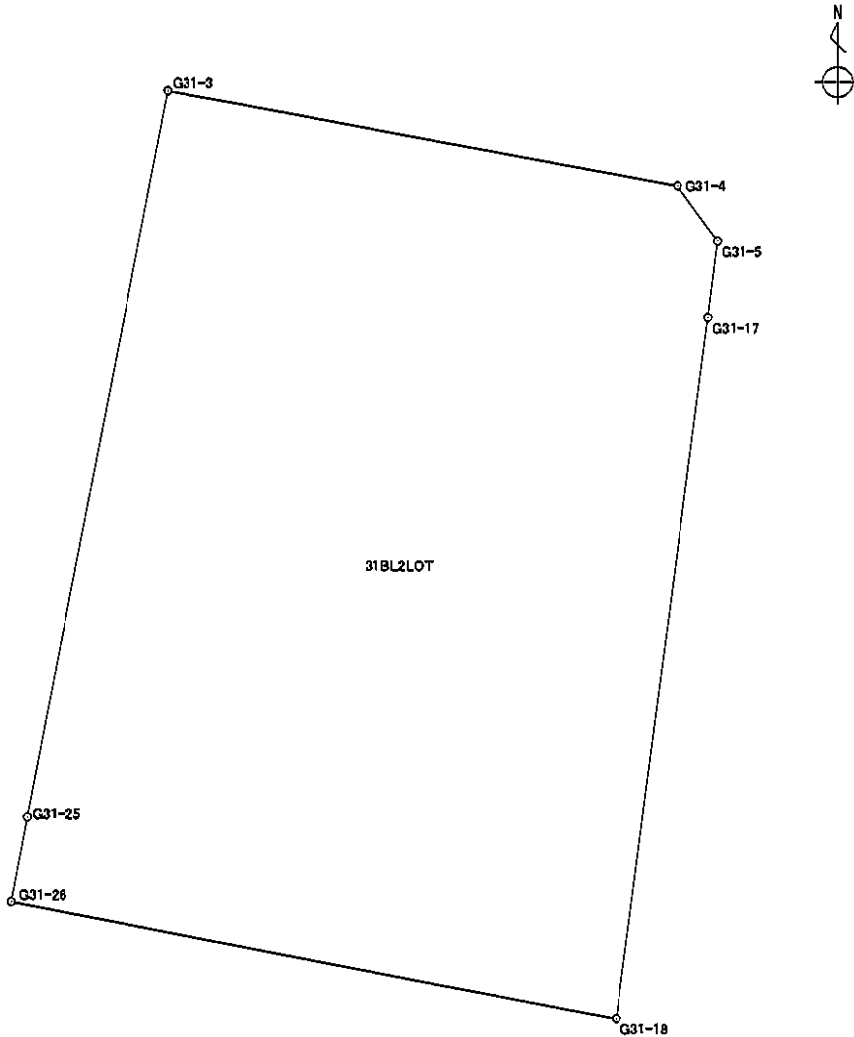


| | | | |
|-----------------------------------------------------------------|----|-------------|--------|
| 面積算出公式 $A = \frac{1}{2} \sum X_n \times (Y_{n+1} - Y_{n-1})$ | 面積 | 432.1125095 | 土地の所在 |
| | 地積 | 432.11 | 土地の所有者 |

座 標 面 積 計 算 書

世界測地系

地番 31BL4LOT


地目
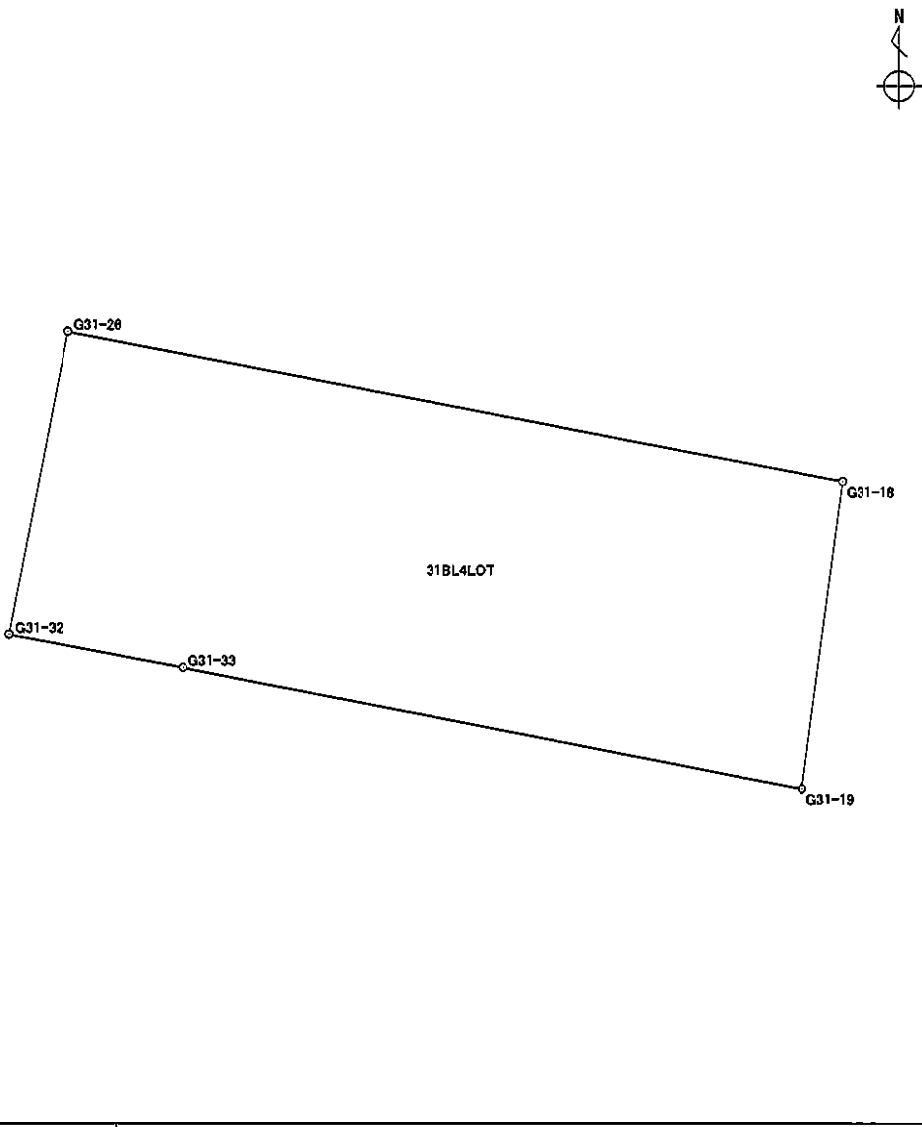
| 境界点 | X 座標 | Y 座標 | 辺長 | 方向角 | 備考 |  | | | |
|-------------------------------------------------------|-------------|------------|-------------|--------------|----|--------------------------------------------------------------------------------------|--|--|--|
| G31-18 | -151145.042 | -38885.566 | 7.209 | 187° 26' 12" | | | | | |
| G31-19 | -151152.190 | -38886.499 | 14.599 | 280° 59' 37" | | | | | |
| G31-33 | -151149.406 | -38900.830 | 4.077 | 280° 59' 15" | | | | | |
| G31-32 | -151148.629 | -38904.832 | 7.195 | 10° 48' 53" | | | | | |
| G31-26 | -151141.562 | -38903.482 | 18.251 | 100° 59' 32" | | | | | |
| | | | | | | | | | |
| | | | | | | | | | |
| 面積算出公式 | | 面積 | 132.8353440 | | | 土地の所在 | | | |
| $A = \frac{1}{2} \sum X_n \times (Y_{n+1} - Y_{n-1})$ | | 地積 | 132.83 | | | 土地の所有者 | | | |

座標面積計算書

世界測地系


| | | | |
|----|----------|----|--|
| 地番 | 31BL5LOT | 地目 | |
|----|----------|----|--|
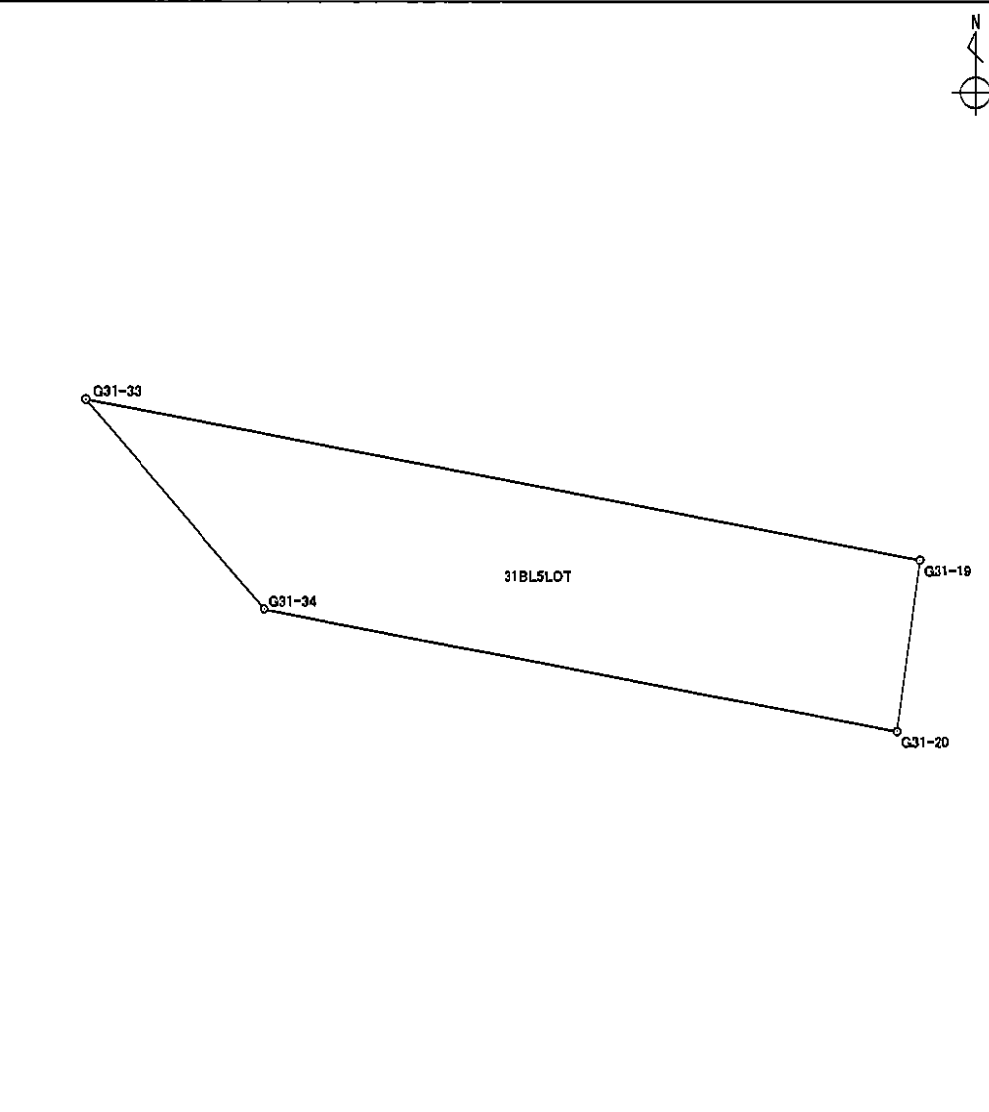
| 境界点 | X座標 | Y座標 | 辺長 | 方向角 | 備考 |  | | | | |
|-------------------------------------------------------|-------------|------------|--------|--------------|----|--------------------------------------------------------------------------------------|------------|--|--------|--|
| G31-19 | -151152.190 | -38886.499 | 2.990 | 187° 27' 19" | | | | | | |
| G31-20 | -151155.155 | -38886.887 | 11.097 | 280° 59' 35" | | | | | | |
| G31-34 | -151153.039 | -38897.780 | 4.744 | 319° 59' 08" | | | | | | |
| G31-33 | -151149.406 | -38900.830 | 14.599 | 100° 59' 37" | | | | | | |
| | | | | | | | | | | |
| | | | | | | | | | | |
| 面積算出公式 | | | | | | 面積 | 38.3460380 | | 土地の所在 | |
| $A = \frac{1}{2} \sum X_n \times (Y_{n+1} - Y_{n-1})$ | | | | | | 地積 | 38.34 | | 土地の所有者 | |

座 標 面 積 計 算 書

| | | | |
|----|----------|----|--|
| 地番 | 31BL6LOT | 地目 | |
|----|----------|----|--|

| 境界点 | X 座標 | Y 座標 | 辺長 | 方向角 | 備考 |
|--------|-------------|------------|--------|--------------|----|
| G31-20 | -151155.155 | -38886.887 | 6.586 | 187° 26' 28" | |
| G31-21 | -151161.686 | -38887.740 | 0.017 | 290° 33' 22" | |
| G31-22 | -151161.680 | -38887.756 | 2.883 | 187° 25' 59" | |
| G31-35 | -151164.539 | -38888.129 | 15.013 | 319° 59' 46" | |
| G31-34 | -151153.039 | -38897.780 | 11.097 | 100° 59' 35" | |
| | | | | | |
| | | | | | |
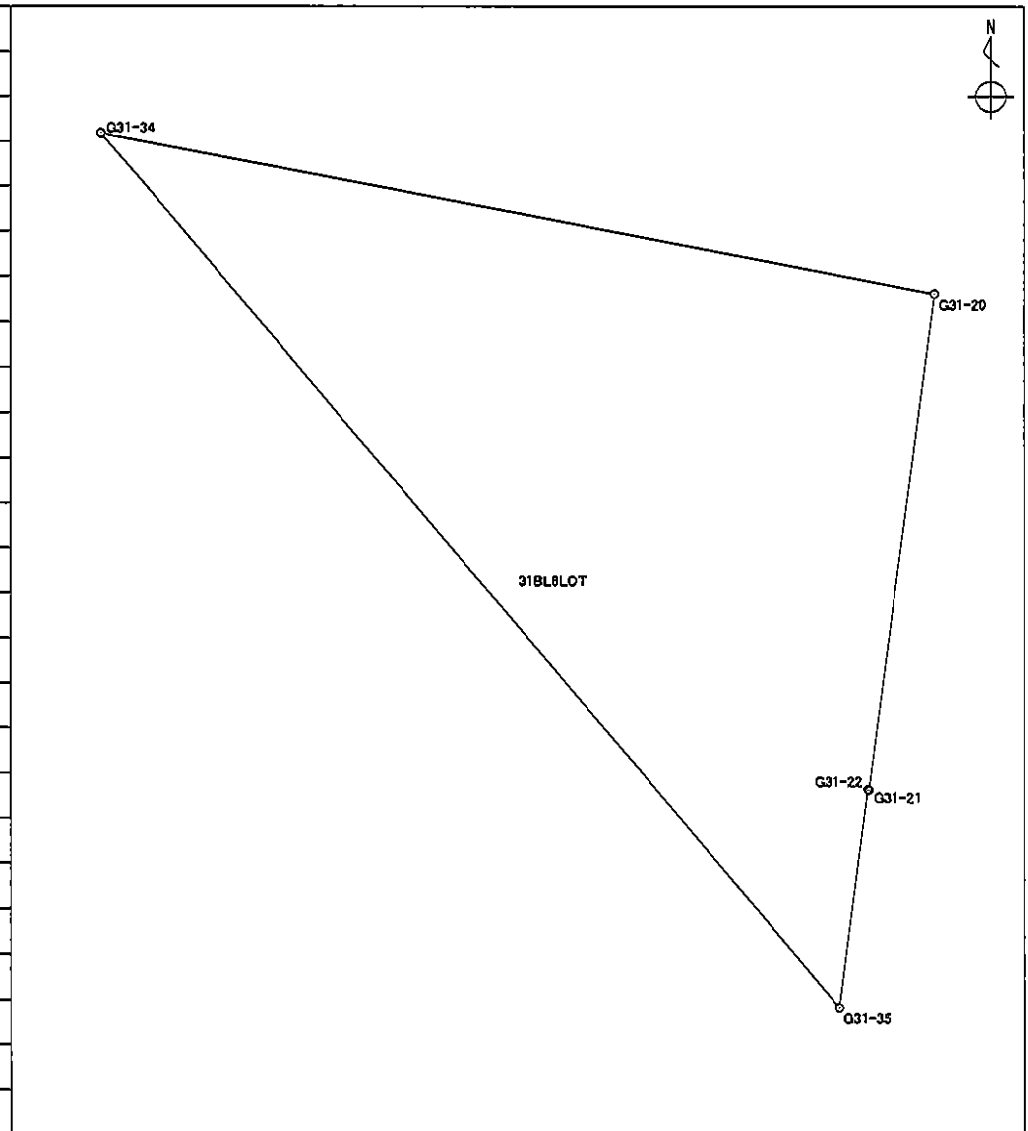


| | | | | | |
|-------------------------------------------------------|--|----|------------|--------|--|
| 面積算出公式 | | 面積 | 52.4534760 | 土地の所在 | |
| $A = \frac{1}{2} \sum X_n \times (Y_{n+1} - Y_{n-1})$ | | 地積 | 52.45 | 土地の所有者 | |

座標面積計算書

世界測地系

| | | | |
|----|----------|----|--|
| 地番 | 31BL7LOT | 地目 | |
|----|----------|----|--|

| 境界点 | X座標 | Y座標 | 辺長 | 方向角 | 備考 |
|--------|-------------|------------|--------|--------------|----|
| G31-38 | -151170.343 | -38931.463 | 22.908 | 10° 47' 10" | |
| G31-14 | -151147.840 | -38927.176 | 14.624 | 100° 47' 29" | |
| G31-29 | -151150.578 | -38912.811 | 22.908 | 190° 35' 15" | |
| G31-30 | -151173.096 | -38917.020 | 14.703 | 280° 47' 30" | |
| | | | | | |
| | | | | | |
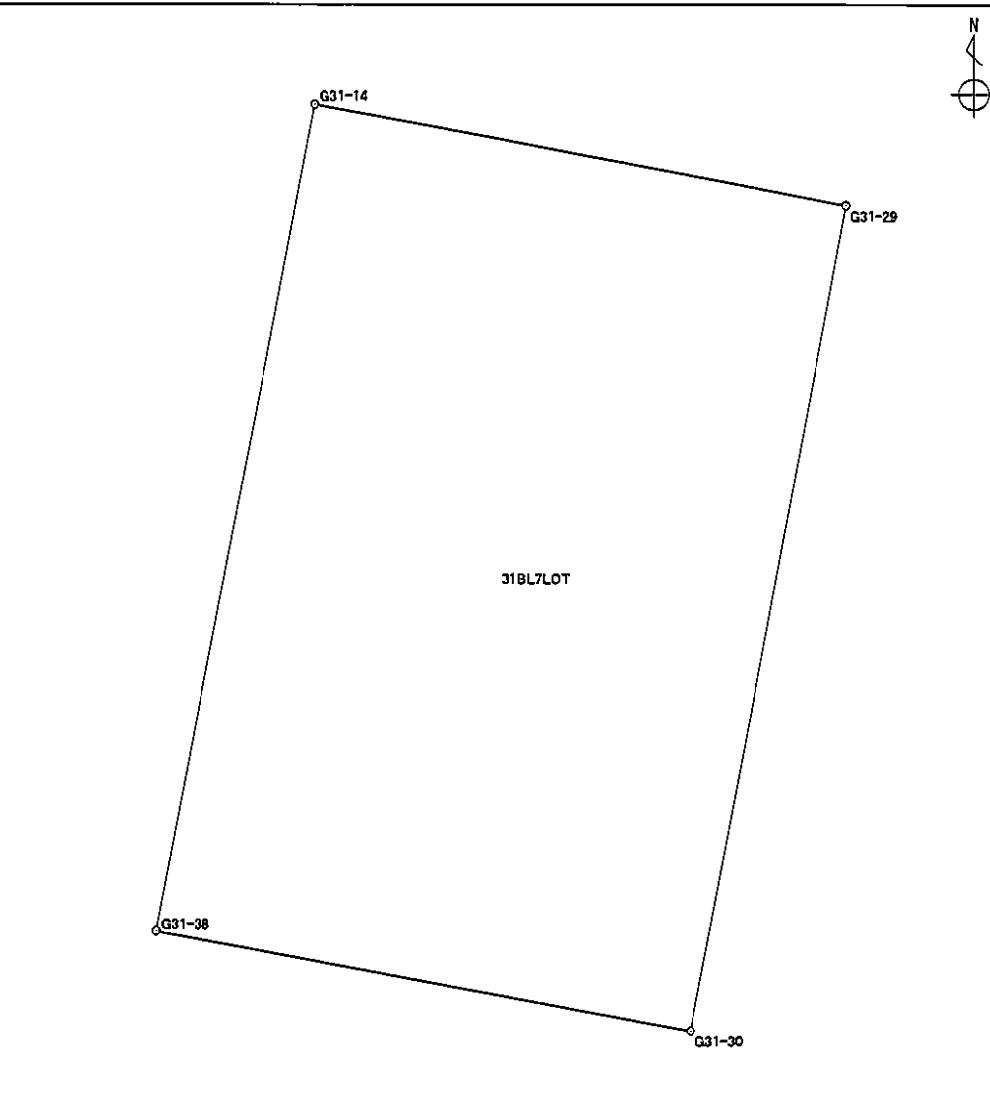


| | | | | |
|-----------------------------------------------------------------|----|-------------|--------|--|
| 面積算出公式 $A = \frac{1}{2} \sum X_n \times (Y_{n+1} - Y_{n-1})$ | 面積 | 335.9041260 | 土地の所在 | |
| | 地積 | 335.90 | 土地の所有者 | |

座標面積計算書

地番 31BL8LOT

地目

| 境界点 | X座標 | Y座標 | 辺長 | 方向角 | 備考 |
|--------|-------------|------------|--------|--------------|----|
| G31-14 | -151147.840 | -38927.176 | 10.604 | 10° 47' 00" | |
| G31-15 | -151137.423 | -38925.192 | 14.587 | 100° 47' 41" | |
| G31-27 | -151140.155 | -38910.863 | 10.154 | 190° 35' 22" | |
| G31-28 | -151150.136 | -38912.729 | 0.450 | 190° 30' 36" | |
| G31-29 | -151150.578 | -38912.811 | 14.624 | 280° 47' 29" | |
| | | | | | |
| | | | | | |
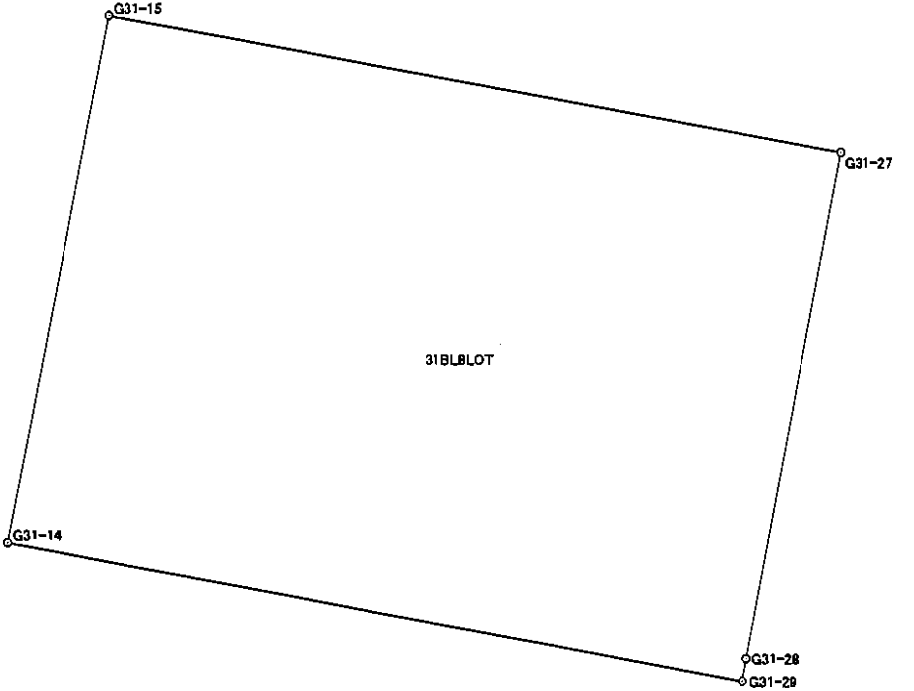


| | | | |
|-----------------------------------------------------------------|----|-------------|--------|
| 面積算出公式 $A = \frac{1}{2} \sum X_n \times (Y_{n+1} - Y_{n-1})$ | 面積 | 154.8695850 | 土地の所在 |
| | 地積 | 154.86 | 土地の所有者 |

座標面積計算書

| | | | |
|----|----------|----|--|
| 地番 | 31BL9LOT | 地目 | |
|----|----------|----|--|

| 境界点 | X座標 | Y座標 | 辺長 | 方向角 | 備考 |
|--------|-------------|------------|--------|--------------|----|
| G31-15 | -151137.423 | -38925.192 | 2.559 | 10° 45' 56" | |
| G31-16 | -151134.909 | -38924.714 | 22.103 | 100° 47' 34" | |
| G31-25 | -151139.048 | -38903.002 | 2.559 | 190° 48' 34" | |
| G31-26 | -151141.562 | -38903.482 | 7.514 | 280° 47' 33" | |
| G31-27 | -151140.155 | -38910.863 | 14.587 | 280° 47' 41" | |
| | | | | | |
| | | | | | |
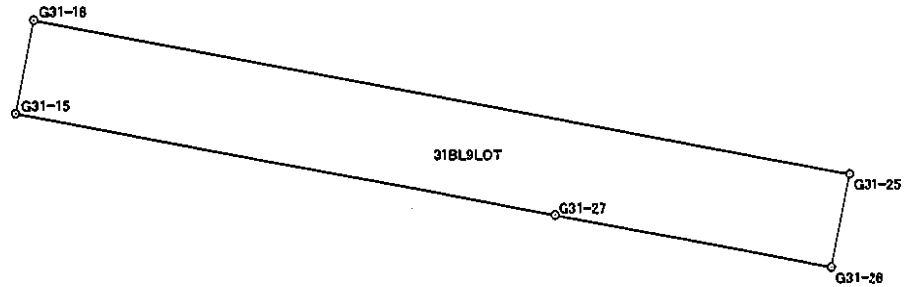


| | | | | |
|-----------------------------------------------------------------|----|------------|--------|--|
| 面積算出公式 $A = \frac{1}{2} \sum X_n \times (Y_{n+1} - Y_{n-1})$ | 面積 | 56.5660295 | 土地の所在 | |
| | 地積 | 56.56 | 土地の所有者 | |

座標面積計算書

世界測地系

地番 31BL10LOT 地目

| 境界点 | X座標 | Y座標 | 辺長 | 方向角 | 備考 |
|--------|-------------|------------|--------|--------------|----|
| G31-35 | -151164.539 | -38888.129 | 8.244 | 187° 26' 35" | |
| G31-23 | -151172.714 | -38889.197 | 0.021 | 129° 05' 38" | |
| G31-24 | -151172.727 | -38889.181 | 8.274 | 187° 12' 24" | |
| G31-8 | -151180.936 | -38890.219 | 2.242 | 233° 17' 19" | |
| G31-9 | -151182.276 | -38892.016 | 16.858 | 279° 23' 55" | |
| G31-10 | -151179.523 | -38908.648 | 4.974 | 9° 23' 46" | |
| G31-36 | -151174.616 | -38907.836 | 9.309 | 279° 23' 51" | |
| G31-30 | -151173.096 | -38917.020 | 22.908 | 10° 35' 15" | |
| G31-29 | -151150.578 | -38912.811 | 0.450 | 10° 30' 36" | |
| G31-28 | -151150.136 | -38912.729 | 15.228 | 100° 59' 23" | |
| G31-34 | -151153.039 | -38897.780 | 15.013 | 139° 59' 46" | |
| | | | | | |
| | | | | | |
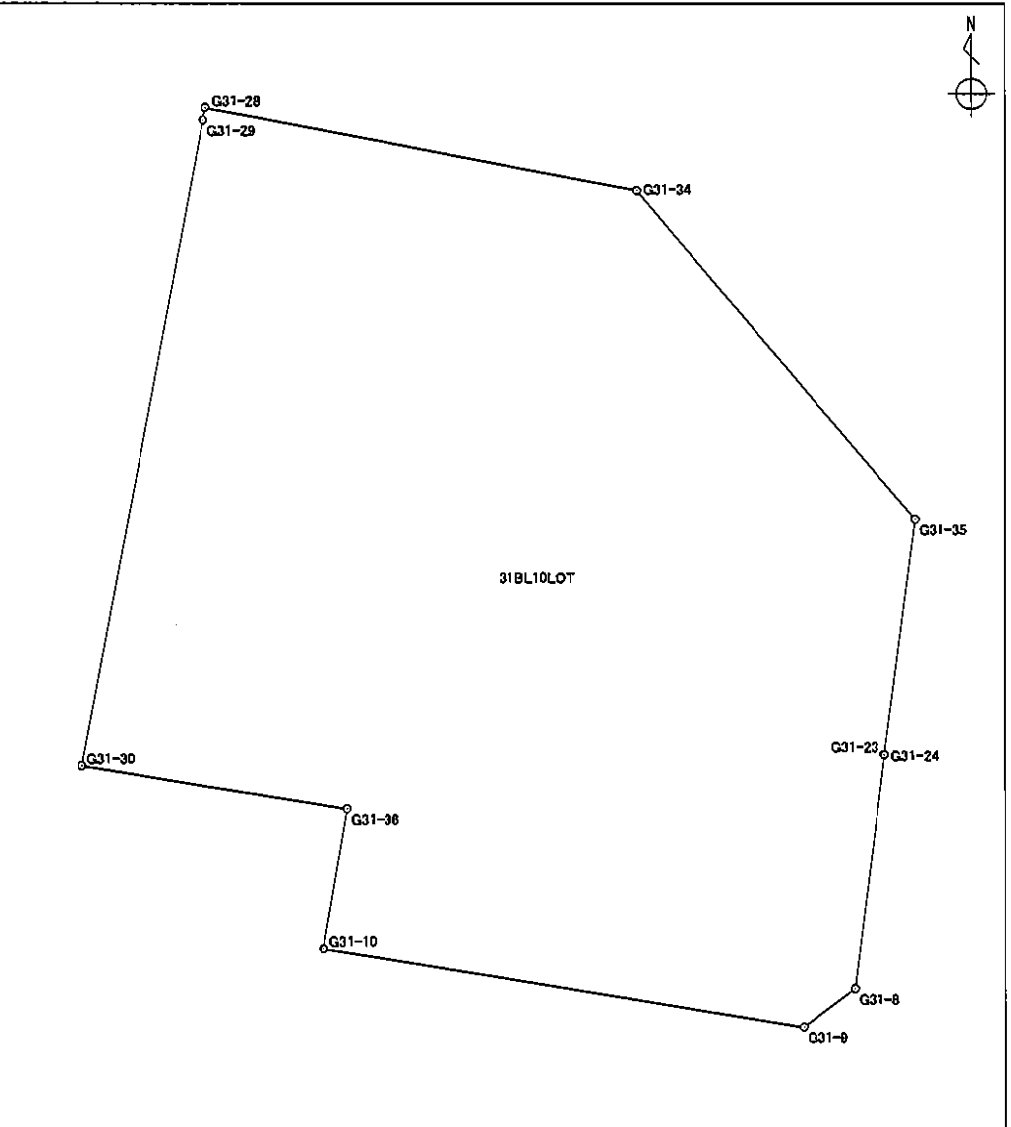


| | | | | |
|-------------------------------------------------------|----|-------------|--------|--|
| 面積算出公式 | 面積 | 656.8048235 | 土地の所在 | |
| $A = \frac{1}{2} \sum X_n \times (Y_{n+1} - Y_{n-1})$ | 地積 | 656.80 | 土地の所有者 | |

座 標 面 積 計 算 書

世界測地系

| | | | |
|----|-----------|----|--|
| 地番 | 31BL11LOT | 地目 | |
|----|-----------|----|--|

| 境界点 | X座標 | Y座標 | 辺長 | 方向角 | 備考 |
|--------|-------------|------------|-------|--------------|----|
| G31-10 | -151179.523 | -38908.648 | 9.413 | 279° 24' 15" | |
| G31-11 | -151177.985 | -38917.934 | 3.286 | 10° 35' 31" | |
| G31-31 | -151174.755 | -38917.330 | 1.688 | 10° 35' 03" | |
| G31-30 | -151173.096 | -38917.020 | 9.309 | 99° 23' 51" | |
| G31-36 | -151174.616 | -38907.836 | 4.974 | 189° 23' 46" | |
| | | | | | |
| | | | | | |
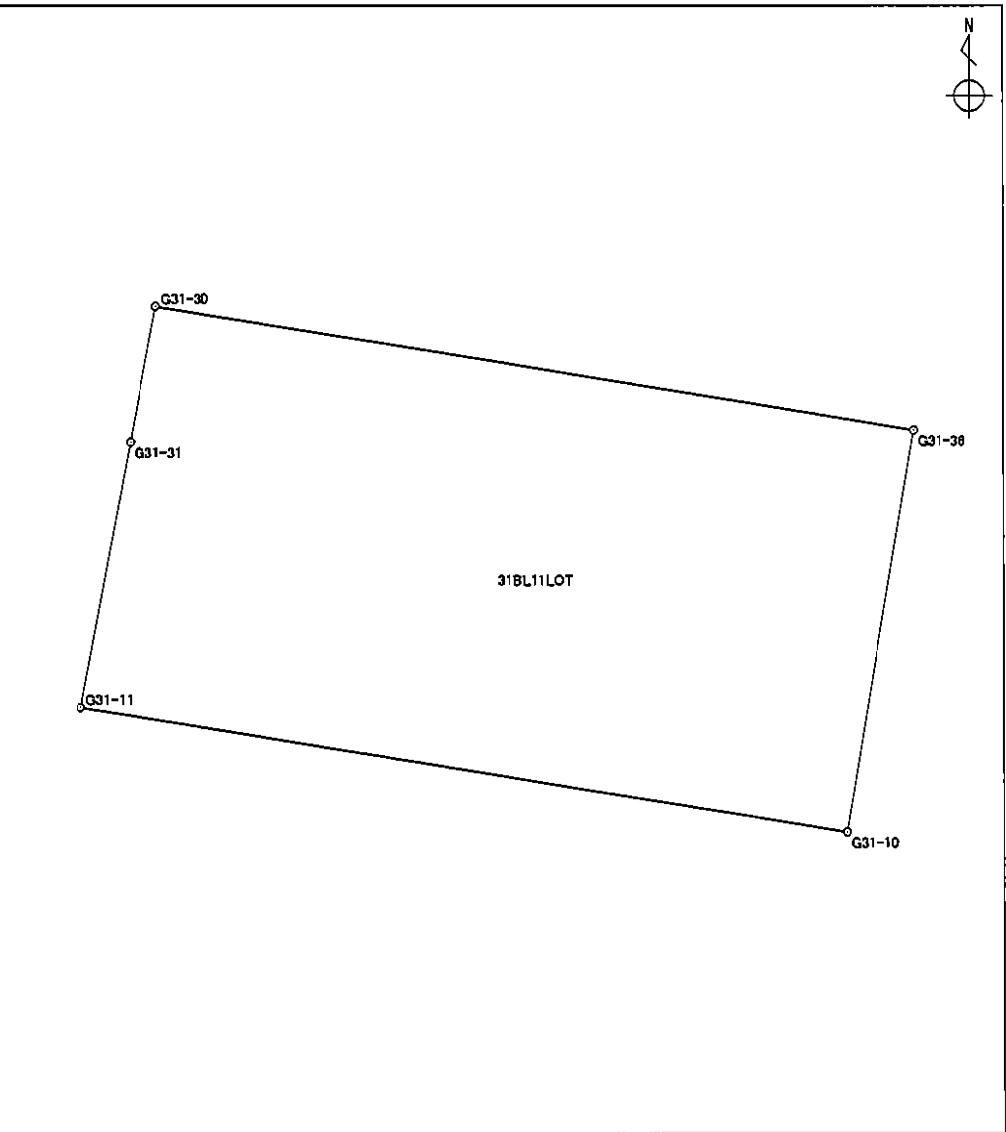


| | | | | | |
|-------------------------------------------------------|--|----|------------|--------|--|
| 面積算出公式 | | 面積 | 46.5521890 | 土地の所在 | |
| $A = \frac{1}{2} \sum X_n \times (Y_{n+1} - Y_{n-1})$ | | 地積 | 46.55 | 土地の所有者 | |

座 標 面 積 計 算 書

世界測地系

地番 31BL12LOT 地目

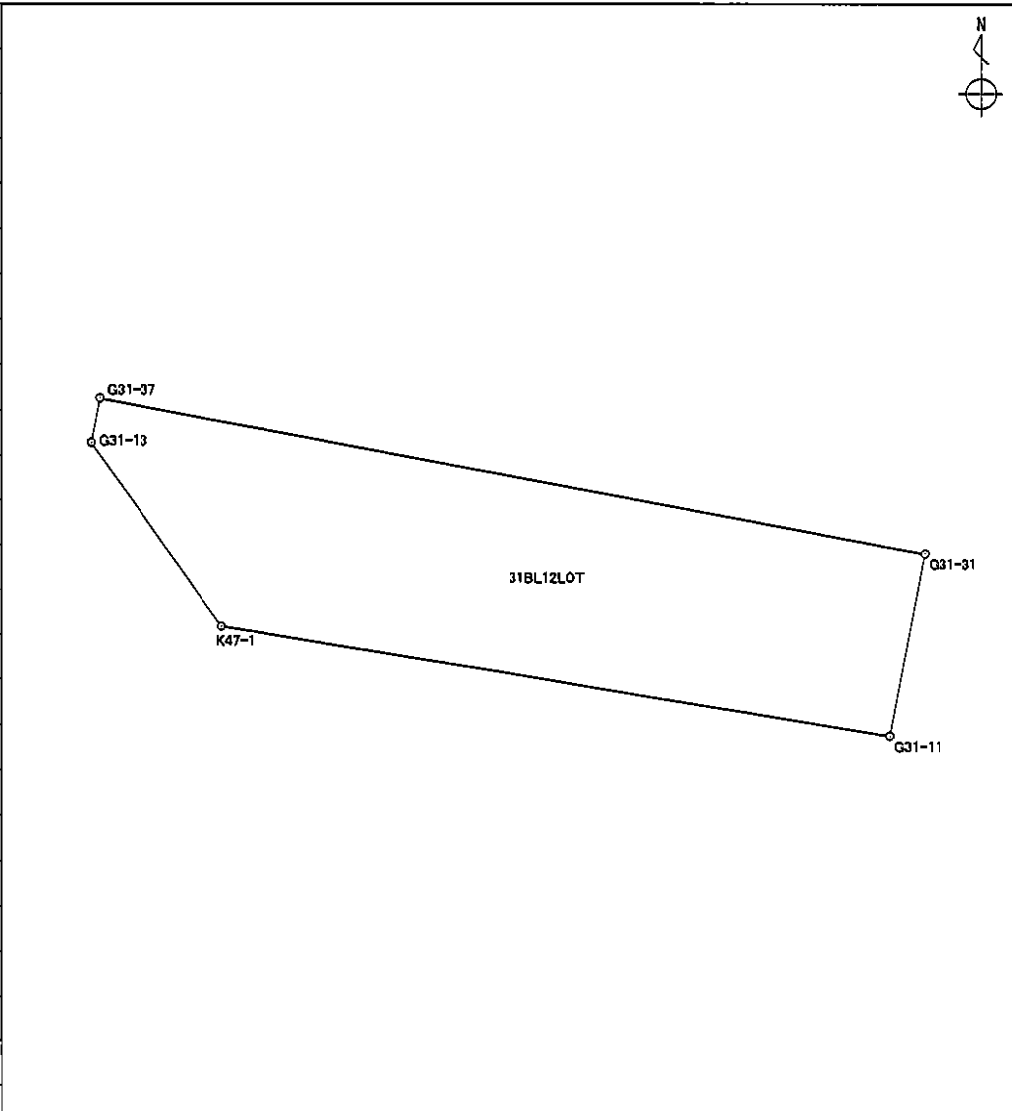
| 境界点 | X 座標 | Y 座標 | 辺長 | 方向角 | 備考 |  |
|--------|-------------|------------|--------|--------------|----|--------------------------------------------------------------------------------------|
| G31-11 | -151177.985 | -38917.934 | 11.880 | 279° 23' 53" | | |
| K47-1 | -151176.045 | -38929.655 | 3.975 | 325° 07' 21" | | |
| G31-13 | -151172.784 | -38931.928 | 0.797 | 10° 46' 27" | | |
| G31-37 | -151172.001 | -38931.779 | 14.709 | 100° 47' 28" | | |
| G31-31 | -151174.755 | -38917.330 | 3.286 | 190° 35' 31" | | |
| | | | | | | |
| | | | | | | |
| | | | | |
|-------------------------------------------------------|-----|------------|--------|--|
| 面積算出公式 | 面 積 | 46.9392490 | 土地の所在 | |
| $A = \frac{1}{2} \sum X_n \times (Y_{n+1} - Y_{n-1})$ | 地 積 | 46.93 | 土地の所有者 | |

座 標 面 積 計 算 書

世界測地系

| | | | |
|----|-----------|----|--|
| 地番 | 31BL13LOT | 地目 | |
|----|-----------|----|--|

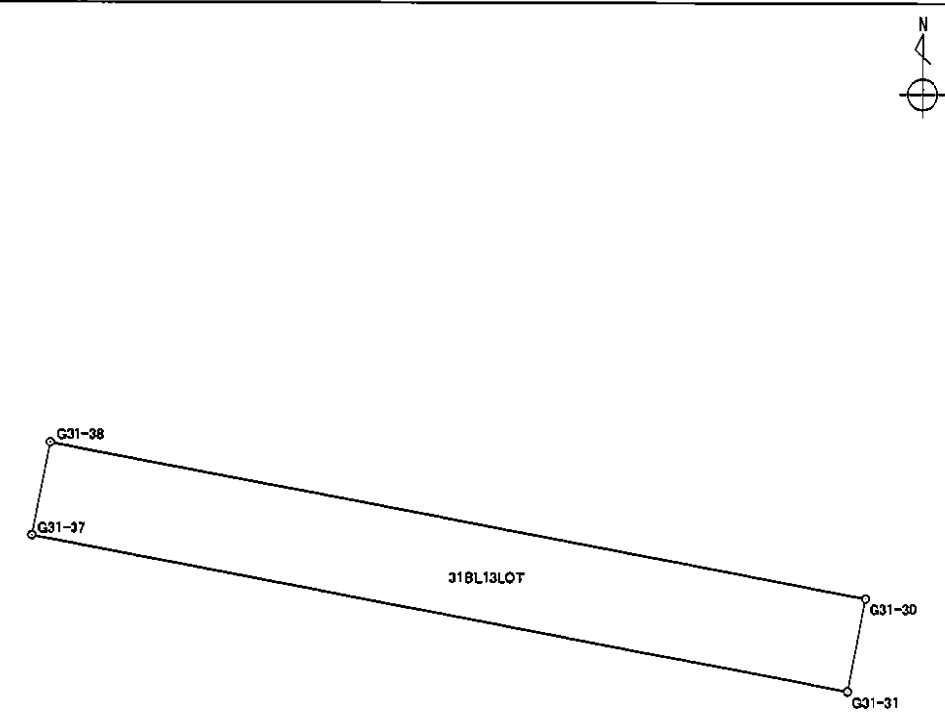
| 境界点 | X 座標 | Y 座標 | 辺長 | 方向角 | 備考 | | |
|-------------------------------------------------------|-------------|------------|--------|--------------|--------|--------------------------------------------------------------------------------------|--|
| G31-37 | -151172.001 | -38931.779 | 1.688 | 10° 47' 26" | |  | |
| G31-38 | -151170.343 | -38931.463 | 14.703 | 100° 47' 30" | | | |
| G31-30 | -151173.096 | -38917.020 | 1.688 | 190° 35' 03" | | | |
| G31-31 | -151174.755 | -38917.330 | 14.709 | 280° 47' 28" | | | |
| | | | | | | | |
| | | | | | | | |
| 面積算出公式 | | | 面積 | 24.8205365 | 土地の所在 | | |
| $A = \frac{1}{2} \sum X_n \times (Y_{n+1} - Y_{n-1})$ | | | 地積 | 24.82 | 土地の所有者 | | |

座標面積計算書

世界測地系

地番 31BL14LOT 地目

| 境界点 | X 座標 | Y 座標 | 辺長 | 方向角 | 備考 |
|--------|-------------|------------|--------|--------------|----|
| G31-33 | -151149.406 | -38900.830 | 4.744 | 139° 59' 08" | |
| G31-34 | -151153.039 | -38897.780 | 15.228 | 280° 59' 23" | |
| G31-28 | -151150.136 | -38912.729 | 10.154 | 10° 35' 22" | |
| G31-27 | -151140.155 | -38910.863 | 7.514 | 100° 47' 33" | |
| G31-26 | -151141.562 | -38903.482 | 7.195 | 190° 48' 53" | |
| G31-32 | -151148.629 | -38904.832 | 4.077 | 100° 59' 15" | |
| | | | | | |
| | | | | | |
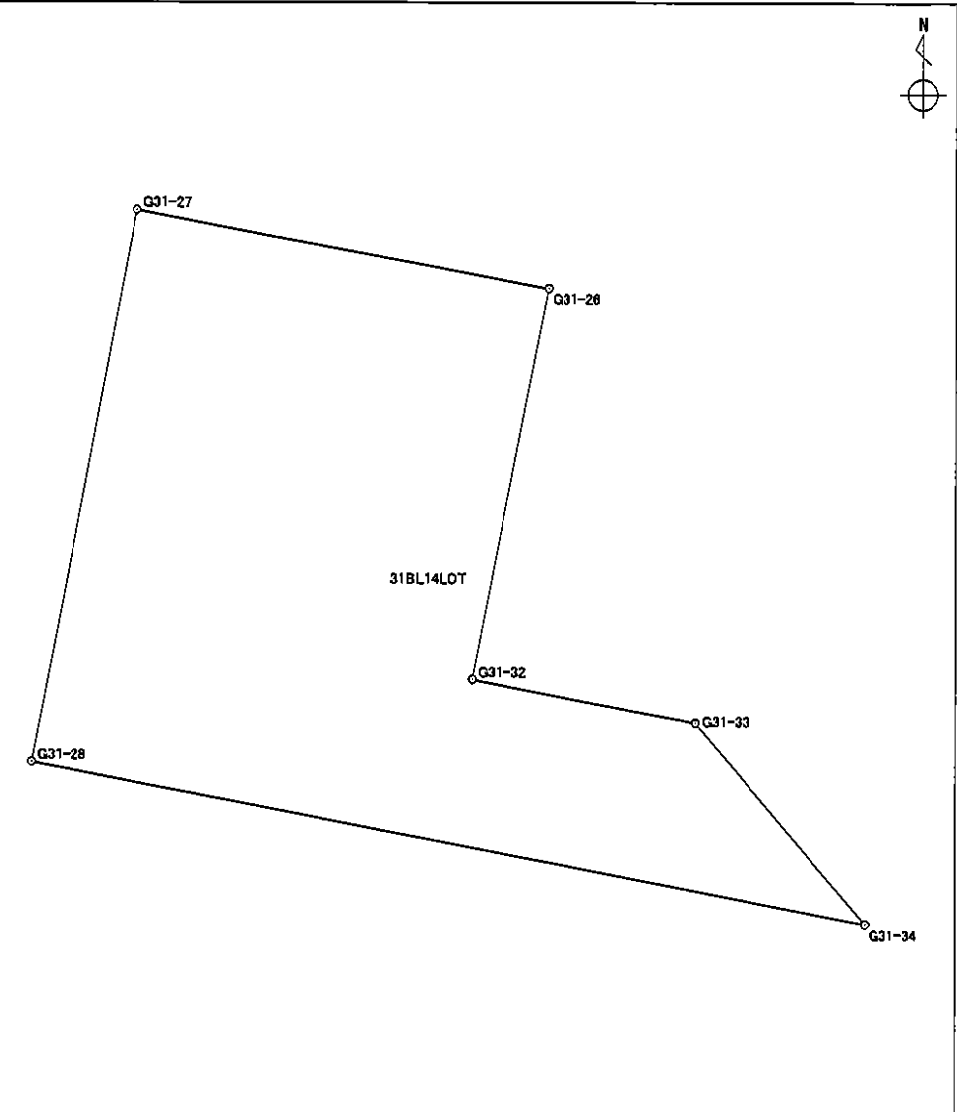


| | | | |
|-------------------------------------------------------|-----------|------------|---------------|
| 面積算出公式 | 面積 | 93.8457110 | 土地の所在 |
| $A = \frac{1}{2} \sum X_n \times (Y_{n+1} - Y_{n-1})$ | 地積 | 93.84 | 土地の所有者 |

座標面積計算書

世界測地系

| | | | |
|----|--------|----|--|
| 地番 | 31BL水路 | 地目 | |
|----|--------|----|--|

| 境界点 | X 座標 | Y 座標 | 辺長 | 方向角 | 備考 |
|--------|-------------|------------|--------|--------------|----|
| G31-5 | -151121.817 | -38882.544 | 2.008 | 144° 21' 46" | |
| G31-6 | -151123.449 | -38881.374 | 56.837 | 187° 24' 13" | |
| G31-7 | -151179.812 | -38888.698 | 1.891 | 233° 32' 10" | |
| G31-8 | -151180.936 | -38890.219 | 8.274 | 7° 12' 24" | |
| G31-24 | -151172.727 | -38889.181 | 0.021 | 309° 05' 38" | |
| G31-23 | -151172.714 | -38889.197 | 8.244 | 7° 26' 35" | |
| G31-35 | -151164.539 | -38888.129 | 2.883 | 7° 25' 59" | |
| G31-22 | -151161.680 | -38887.756 | 0.017 | 110° 33' 22" | |
| G31-21 | -151161.686 | -38887.740 | 6.586 | 7° 26' 28" | |
| G31-20 | -151155.155 | -38886.887 | 2.990 | 7° 27' 19" | |
| G31-19 | -151152.190 | -38886.499 | 7.209 | 7° 26' 12" | |
| G31-18 | -151145.042 | -38885.566 | 21.120 | 7° 26' 36" | |
| G31-17 | -151124.100 | -38882.830 | 2.301 | 7° 08' 26" | |
| | | | | | |
| | | | | | |
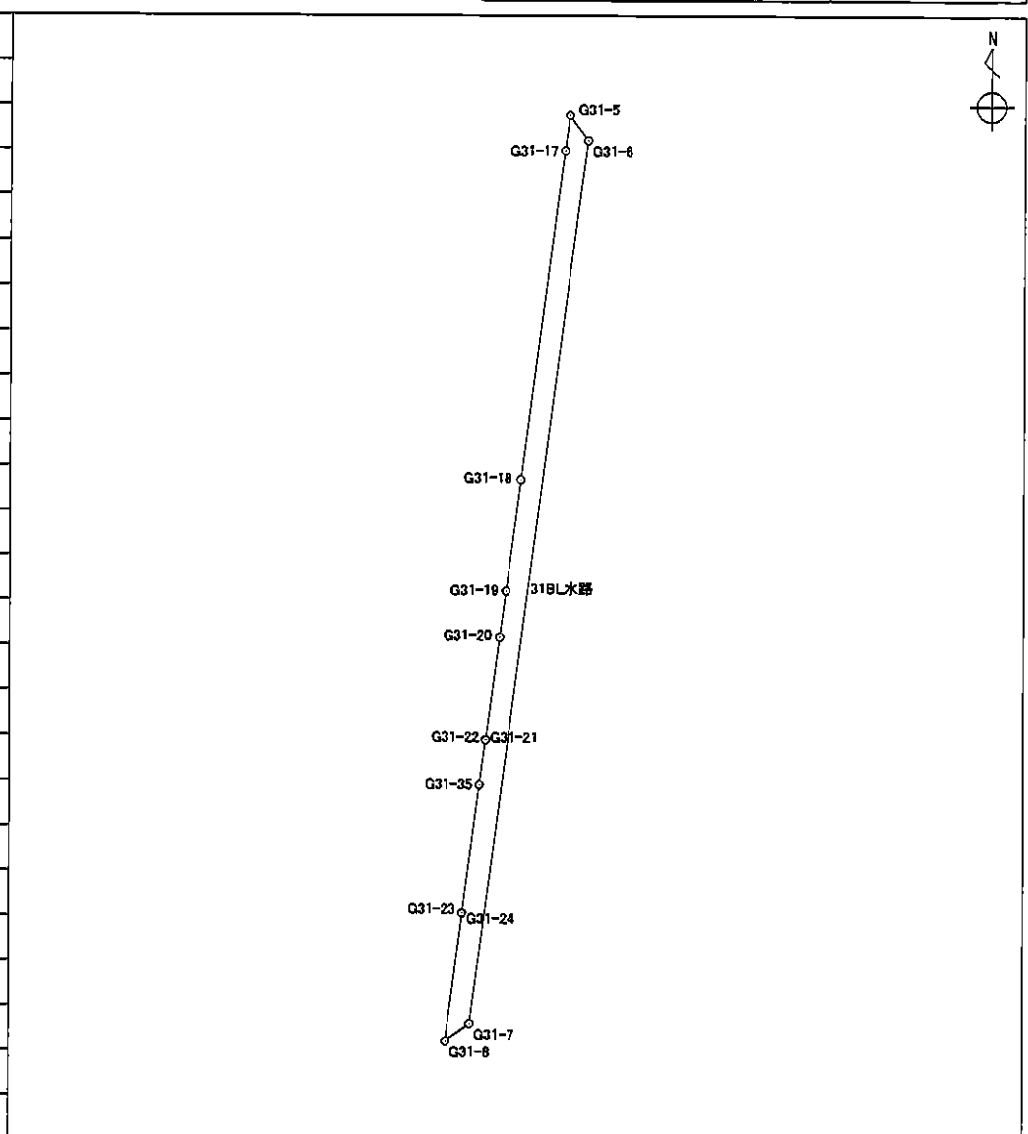

| | | | | |
|-----------------------------------------------------------------|----|------------|--------|--|
| 面積算出公式 $A = \frac{1}{2} \sum X_n \times (Y_{n+1} - Y_{n-1})$ | 面積 | 80.3338520 | 土地の所在 | |
| | 地積 | 80.33 | 土地の所有者 | |