

## 面積集計表

平成 20 年 1 月 16 日


現場名: 平成18・19年度出来形確認測量

所有者	No.	地番No	地番名	面積	地積	坪数
	1	576	33BL1LOT	262.2562520	262.25	79.33
	2	577	33BL2LOT	671.6889870	671.68	203.18
	3	578	33BL4LOT	333.9625680	333.96	101.02
	4	579	33BL5LOT	730.4435700	730.44	220.95
	5	580	33BL6LOT	34.4829610	34.48	10.43
	6	581	33BL7LOT	134.6761625	134.67	40.73
	7	582	33BL8LOT	145.1822060	145.18	43.91
	8	583	33BL9LOT	37.8740890	37.87	11.45
	9	584	33BL10LOT	21.1762885	21.17	6.40
	10	585	33BL11LOT	745.1334420	745.13	225.40
	11	586	33BL12LOT	15.2792855	15.27	4.62
	12	587	33BL13LOT	44.0215085	44.02	13.31
	13	588	33BL14LOT	237.8035320	237.80	71.93
	14	589	33BL15LOT	727.9962245	727.99	220.21
	15	590	33BL16LOT	23.2906250	23.29	7.04
	16	591	33BL17LOT	537.7948125	537.79	162.68
	17	592	33BL18LOT	66.5915365	66.59	20.14
	18	593	33BL19LOT	415.1306170	415.13	125.57
	19	594	33BL20LOT	100.0892300	100.08	30.27
	20	595	33BL21LOT	214.1006345	214.10	64.76
	21	596	33BL22LOT	45.8765525	45.87	13.87
	22	597	33BL23LOT	98.9766695	98.97	29.94

合計			22筆	5643.8277540	5643.73	1707.14
----	--	--	-----	--------------	---------	---------

# 座標面積計算書


地番	33BL1LOT	地目	
----	----------	----	--

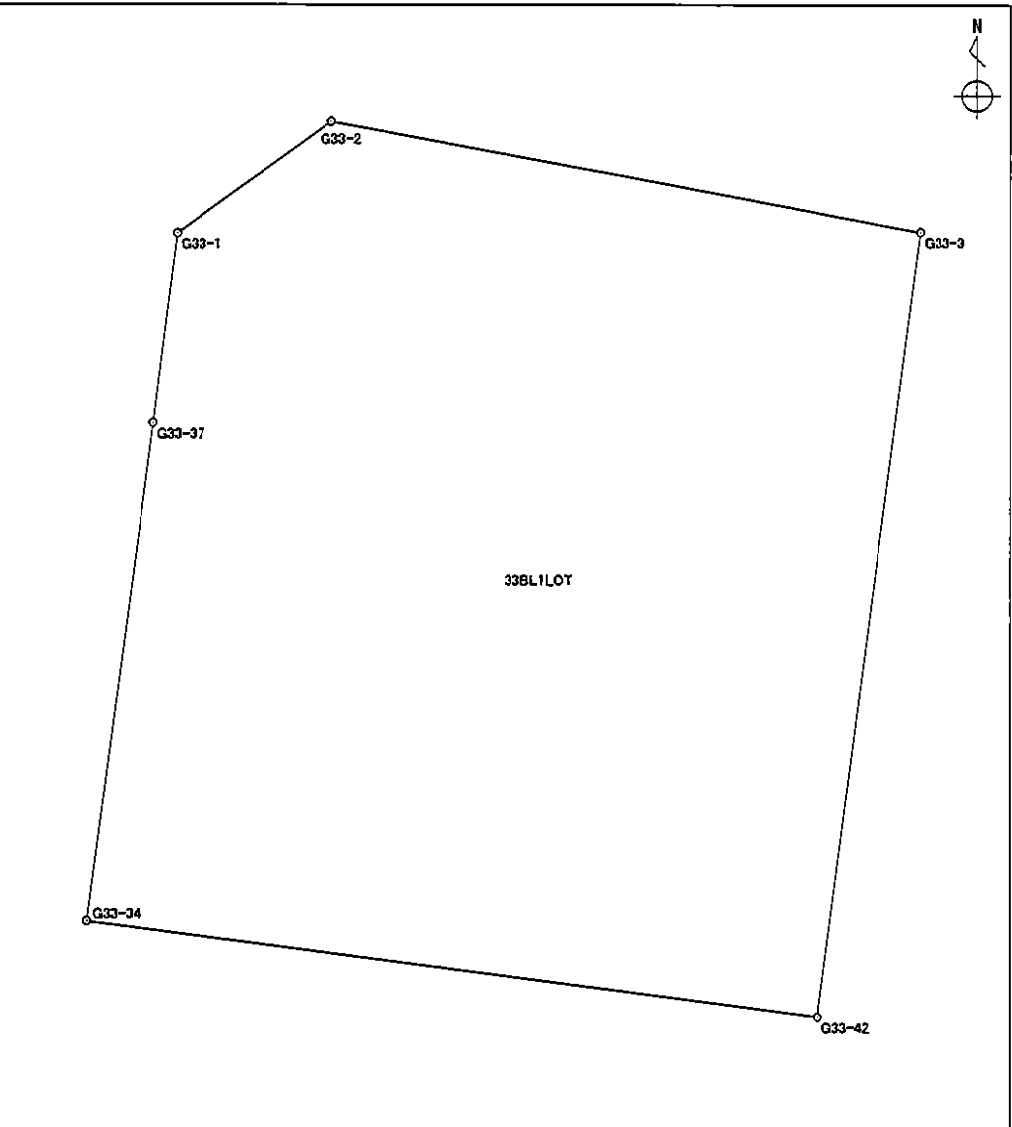境界点	X座標	Y座標	辺長	方向角	備考				
G33-1	-151125.238	-38872.607	4.018	53° 43' 34"					
G33-2	-151122.861	-38869.368	12.615	100° 40' 52"					
G33-3	-151125.199	-38856.972	16.766	187° 25' 09"					
G33-42	-151141.825	-38859.137	15.494	277° 27' 01"					
G33-34	-151139.816	-38874.500	10.644	7° 27' 17"					
G33-37	-151129.262	-38873.119	4.056	7° 15' 04"					
面積算出公式	$A = \frac{1}{2} \sum X_n \times (Y_{n+1} - Y_{n-1})$		面積	262.2562520		土地の所在			
			地積	262.25		土地の所有者			

座標面積計算書

地番	33BL2LOT	地目	
----	----------	----	--

境界点	X座標	Y座標	辺長	方向角	備考
G33-3	-151125.199	-38856.972	8.329	100° 49' 22"	
G33-4	-151126.763	-38848.791	6.002	100° 31' 18"	
G33-5	-151127.859	-38842.890	4.868	100° 22' 47"	
G33-6	-151128.736	-38838.102	5.214	100° 22' 29"	
G33-7	-151129.675	-38832.973	28.070	192° 29' 56"	
G33-46	-151157.080	-38839.048	2.425	277° 06' 27"	
G33-45	-151156.780	-38841.454	0.298	274° 48' 42"	
G33-44	-151156.755	-38841.751	16.304	274° 45' 11"	
G33-76	-151155.404	-38857.999	2.885	274° 45' 08"	
G33-43	-151155.165	-38860.874	13.453	7° 25' 07"	
G33-42	-151141.825	-38859.137	16.766	7° 25' 09"	

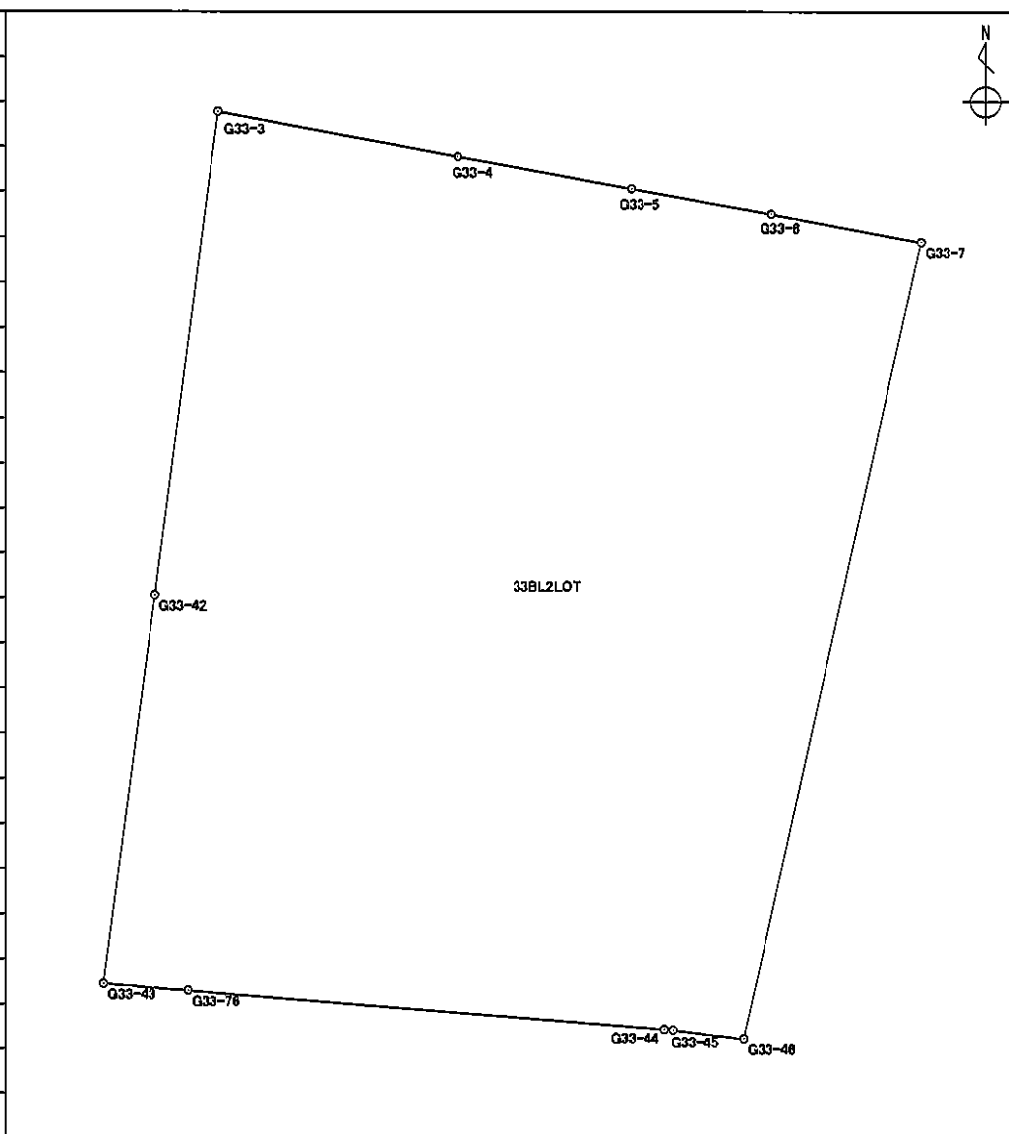


面積算出公式 $A = \frac{1}{2} \sum X_n \times (Y_{n+1} - Y_{n-1})$	面積	671.6889870	土地の所在	
	地積	671.68	土地の所有者	

# 座 標 面 積 計 算 書

世界測地系

地番 33BL4LOT      地目

境 界 点	X 座 標	Y 座 標	辺 長	方 向 角	備 考
G33-7	-151129.675	-38832.973	11.504	100° 38' 41"	
G33-8	-151131.800	-38821.667	27.980	190° 33' 00"	
G33-48	-151159.307	-38826.790	7.554	282° 22' 36"	
G33-47	-151157.688	-38834.168	4.918	277° 06' 07"	
G33-46	-151157.080	-38839.048	28.070	12° 29' 56"	

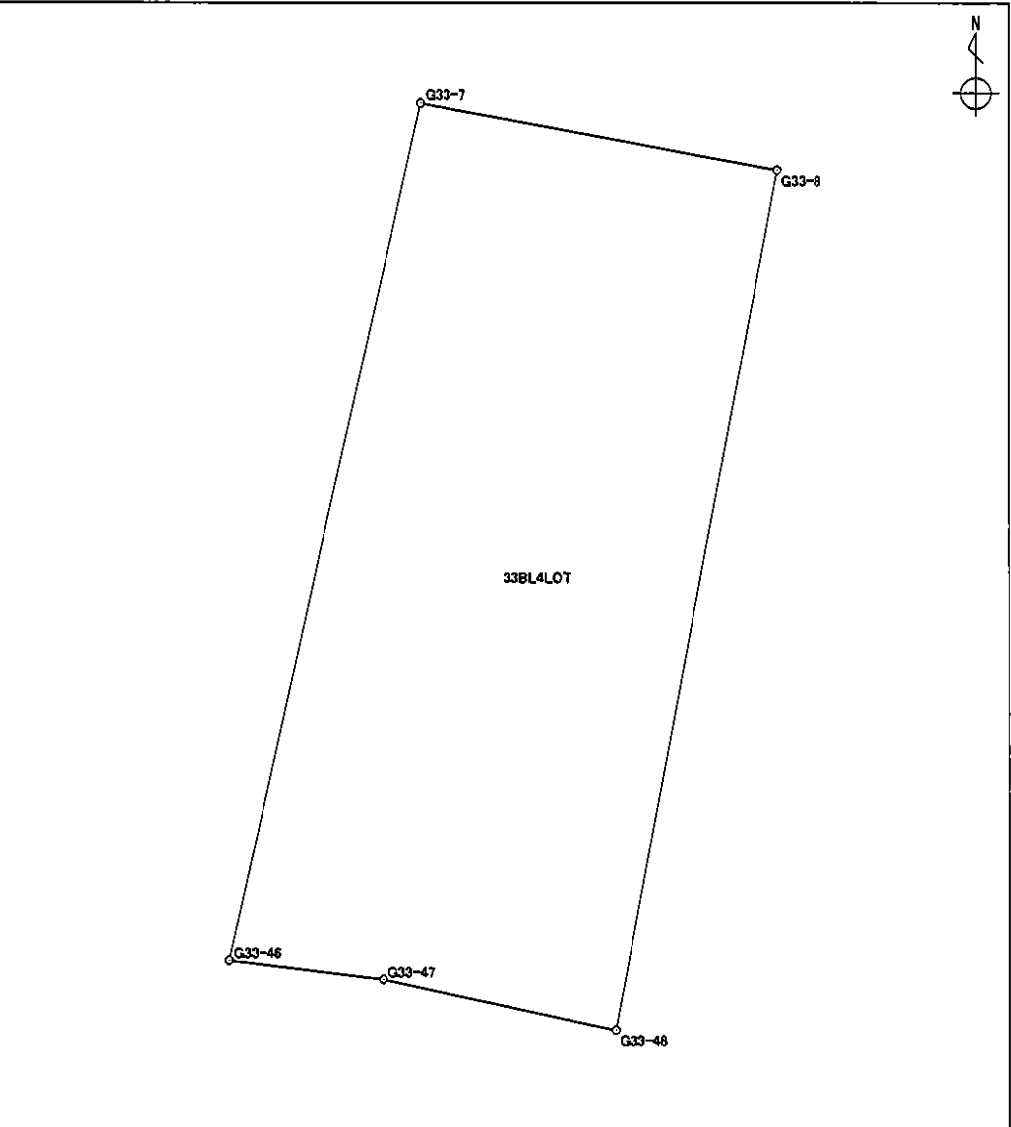


面積算出公式	面 積	333.9625680	土地の所在	
$A = \frac{1}{2} \sum X_n \times (Y_{n+1} - Y_{n-1})$	地 積	333.96	土地の所有者	

# 座標面積計算書

地番 33BL5LOT 地目

境界点	X座標	Y座標	辺長	方向角	備考
G33-8	-151131.800	-38821.667	8.469	100° 38' 57"	
G33-9	-151133.365	-38813.344	16.901	100° 32' 55"	
G33-10	-151136.459	-38796.729	2.702	190° 01' 00"	
G33-56	-151139.120	-38797.199	9.309	190° 01' 41"	
G33-75	-151148.287	-38798.820	3.205	190° 01' 36"	
G33-55	-151151.443	-38799.378	10.259	190° 01' 34"	
G33-54	-151161.545	-38801.164	2.059	190° 02' 36"	
G33-53	-151163.572	-38801.523	1.766	190° 00' 42"	
G33-51	-151165.311	-38801.830	9.251	282° 06' 20"	
G33-50	-151163.371	-38810.875	6.808	287° 04' 30"	
G33-49	-151161.372	-38817.383	9.631	282° 22' 52"	
G33-48	-151159.307	-38826.790	27.980	10° 33' 00"	

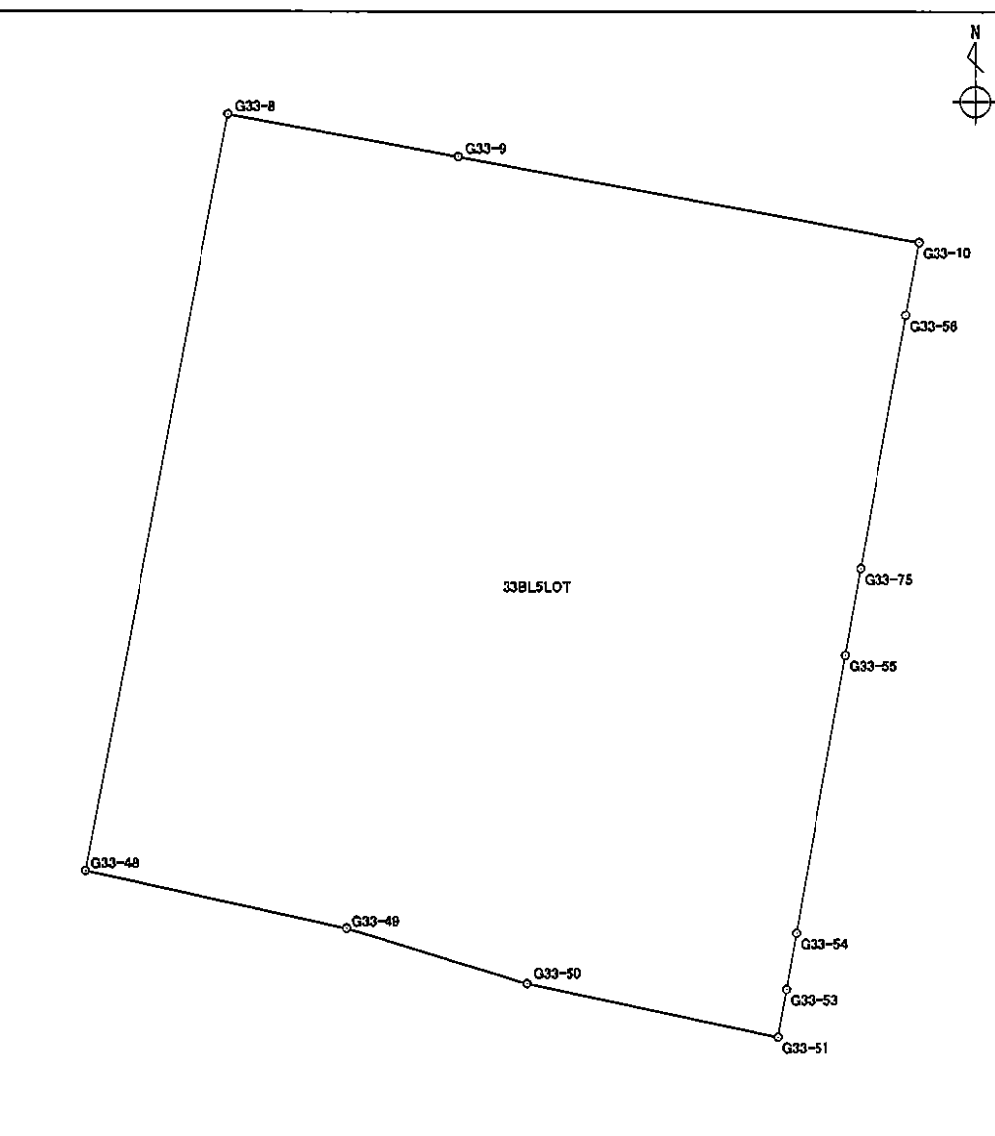
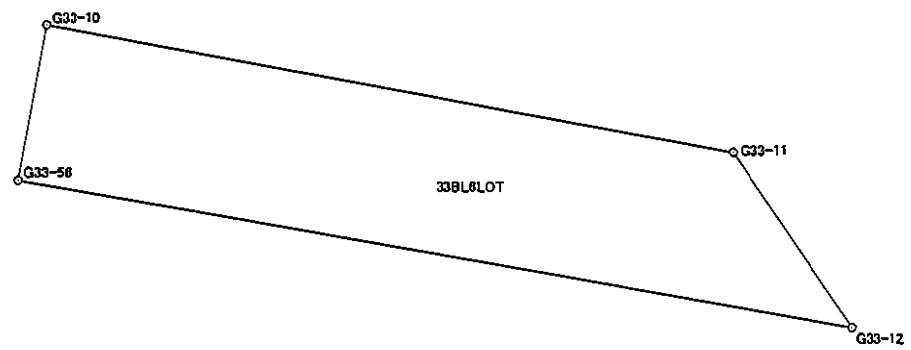


面積算出公式 $A = \frac{1}{2} \sum X_n \times (Y_{n+1} - Y_{n-1})$	面積	730.4435700	土地の所在	
	地積	730.44	土地の所有者	

# 座 標 面 積 計 算 書

世界測地系

地番	33BL6LOT	地目	
----	----------	----	--


境界点	X 座標	Y 座標	辺長	方向角	備考	<div style="text-align: right; margin-bottom: 10px;">  </div> 			
G33-10	-151136.459	-38796.729	11.811	100° 34' 21"					
G33-11	-151138.626	-38785.119	3.600	146° 00' 19"					
G33-12	-151141.611	-38783.106	14.311	280° 01' 26"					
G33-56	-151139.120	-38797.199	2.702	10° 01' 00"					
面積算出公式						面積	34.4829610	土地の所在	
$A = \frac{1}{2} \sum X_n \times (Y_{n+1} - Y_{n-1})$						地積	34.48	土地の所有者	

# 座標面積計算書

世界測地系

地番	33BL7LOT	地目	
----	----------	----	--

境界点	X座標	Y座標	辺長	方向角	備考
G33-12	-151141.611	-38783.106	0.401	146° 04' 20"	
G33-13	-151141.944	-38782.882	2.723	191° 44' 21"	
G33-14	-151144.610	-38783.436	6.301	191° 25' 59"	
G33-74	-151150.786	-38784.685	14.354	280° 01' 34"	
G33-75	-151148.287	-38798.820	9.309	10° 01' 41"	
G33-56	-151139.120	-38797.199	14.311	100° 01' 26"	

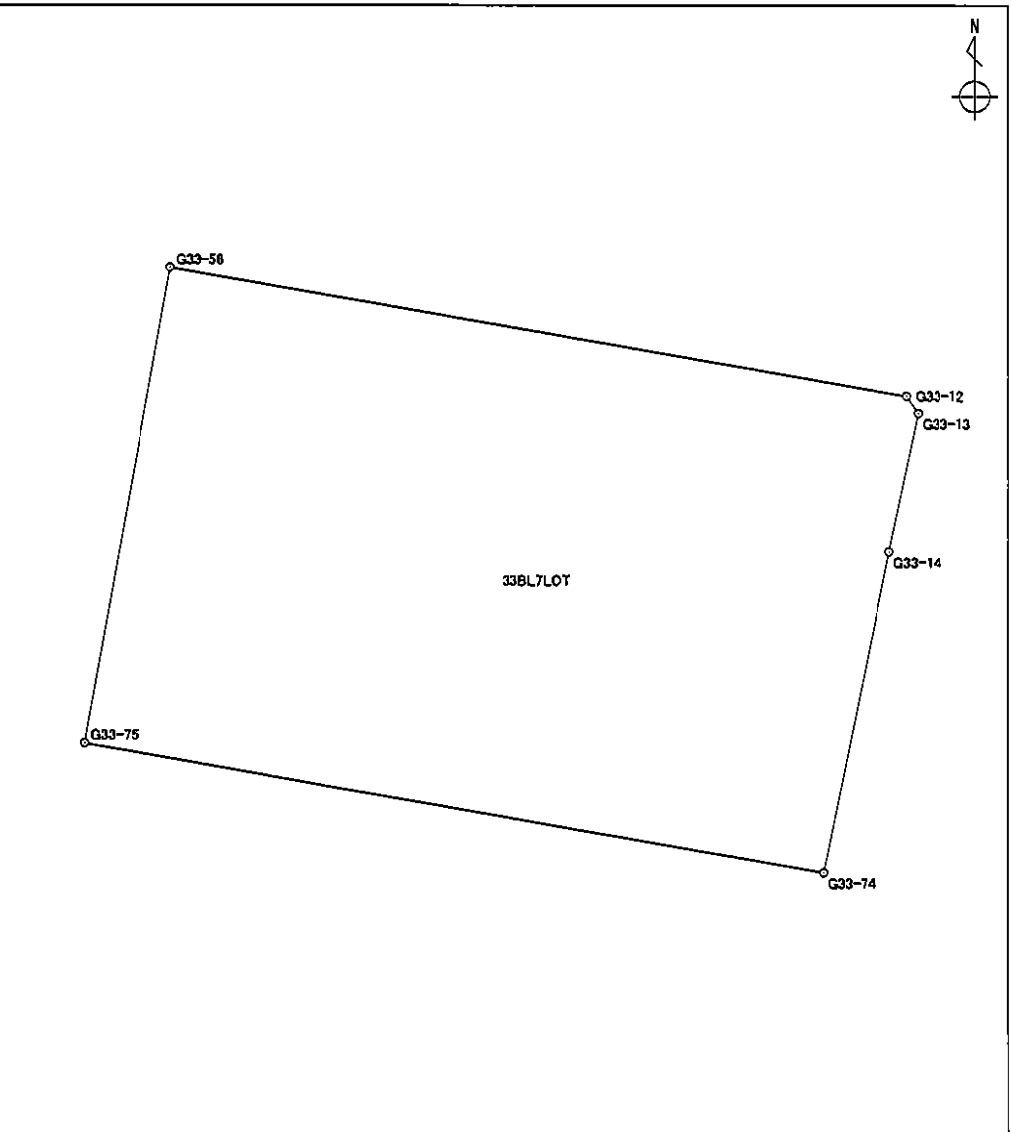

面積算出公式	面積	134.6761625	土地の所在	
$A = \frac{1}{2} \sum X_n \times (Y_{n+1} - Y_{n-1})$	地積	134.67	土地の所有者	




# 座 標 面 積 計 算 書

世界測地系

地番 33BL8LOT	地目
-------------	----

境 界 点	X 座 標	Y 座 標	辺 長	方 向 角	備 考
G33-16	-151153.928	-38785.320	10.262	191° 24' 34"	
G33-17	-151163.987	-38787.350	14.028	280° 01' 30"	
G33-54	-151161.545	-38801.164	10.259	10° 01' 34"	
G33-55	-151151.443	-38799.378	14.276	100° 01' 28"	

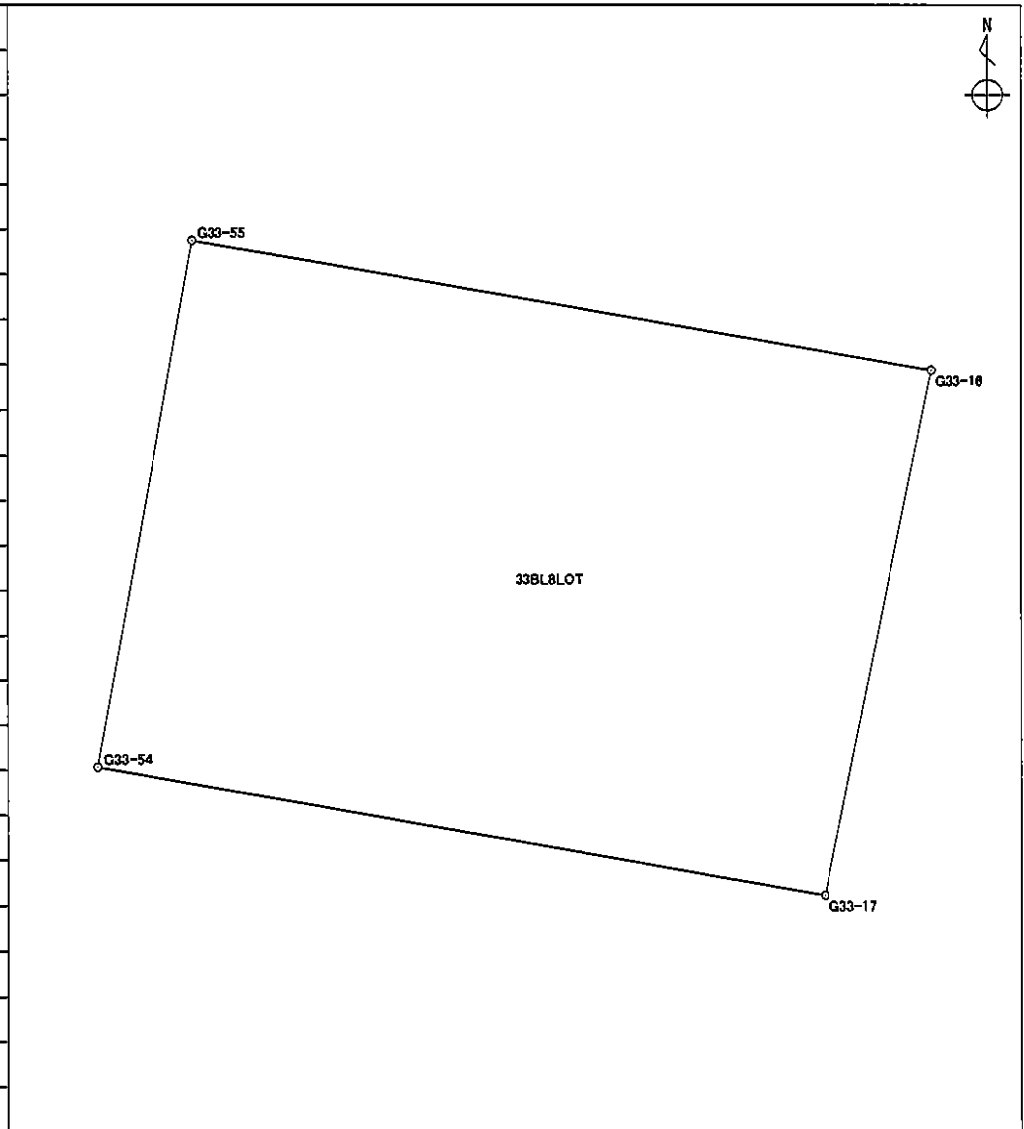


面積算出公式	面 積	145.1822060	土地の所在
$A = \frac{1}{2} \sum X_n \times (Y_{n+1} - Y_{n-1})$	地 積	145.18	土地の所有者



# 座 標 面 積 計 算 書

世界測地系

地番	33BL10LOT	地目	
----	-----------	----	--

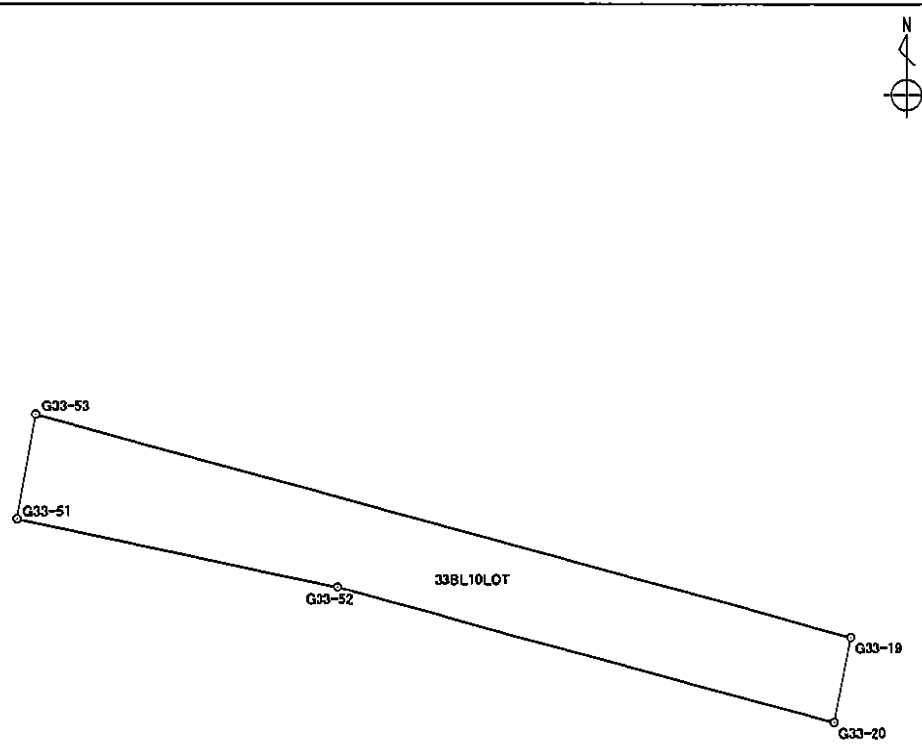
境 界 点	X 座 標	Y 座 標	辺 長	方 向 角	備 考	
G33-19	-151167.277	-38787.998	1.456	190° 53' 08"		
G33-20	-151168.707	-38788.273	8.549	285° 19' 20"		
G33-52	-151166.448	-38796.518	5.432	282° 04' 53"		
G33-51	-151165.311	-38801.830	1.766	10° 00' 42"		
G33-53	-151163.572	-38801.523	14.023	105° 19' 11"		
面積算出公式		面 積	21.1762885		土地の所在	
$A = \frac{1}{2} \sum X_n \times (Y_{n+1} - Y_{n-1})$		地 積	21.17		土地の所有者	

# 座 標 面 積 計 算 書

世界測地系

地番	33BL11LOT	地目	
----	-----------	----	--

境 界 点	X 座 標	Y 座 標	辺 長	方 向 角	備 考
G33-20	-151168.707	-38788.273	8.353	191° 22' 19"	
G33-21	-151176.896	-38789.920	3.328	191° 29' 32"	
G33-22	-151180.157	-38790.583	4.003	281° 24' 40"	
G33-57	-151179.365	-38794.507	4.256	191° 24' 37"	
G33-58	-151183.537	-38795.349	1.123	280° 59' 23"	
G33-59	-151183.323	-38796.451	5.268	191° 23' 12"	
G33-60	-151188.487	-38797.491	2.349	101° 23' 28"	
G33-61	-151188.951	-38795.188	5.528	191° 23' 36"	
G33-62	-151194.370	-38796.280	25.670	281° 23' 52"	
G33-63	-151189.297	-38821.444	23.169	7° 28' 11"	
G33-64	-151166.325	-38818.432	5.063	11° 57' 29"	
G33-49	-151161.372	-38817.383	6.808	107° 04' 30"	
G33-50	-151163.371	-38810.875	9.251	102° 06' 20"	
G33-51	-151165.311	-38801.830	5.432	102° 04' 53"	
G33-52	-151166.448	-38796.518	8.549	105° 19' 20"	

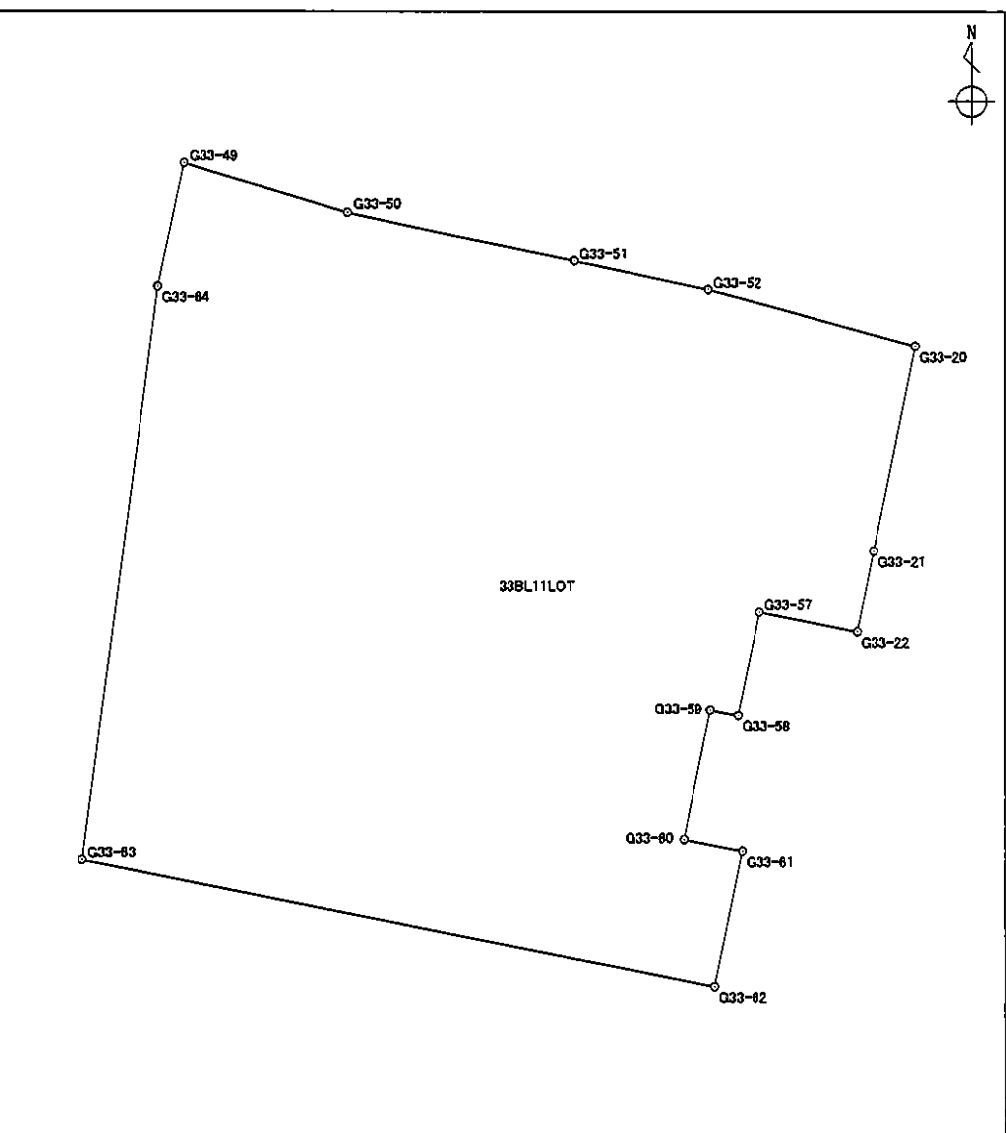


面積算出公式		面積	745.1334420	土地の所在	
$A = \frac{1}{2} \sum X_n \times (Y_{n+1} - Y_{n-1})$		地積	745.13	土地の所有者	

# 座 標 面 積 計 算 書

世界測地系

地番	33BL12LOT	地目	
----	-----------	----	--

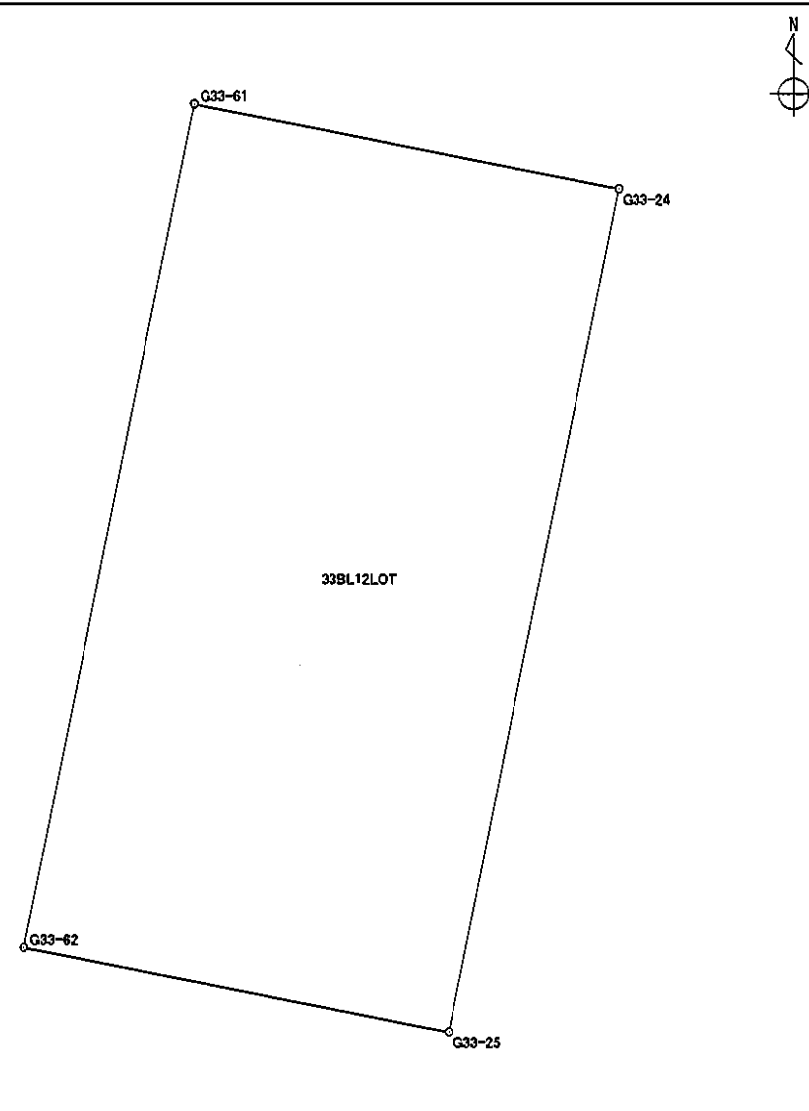境 界 点	X 座 標	Y 座 標	辺 長	方 向 角	備 考	
G33-24	-151189.497	-38792.478	5.528	191° 24' 12"		
G33-25	-151194.916	-38793.571	2.763	281° 23' 43"		
G33-62	-151194.370	-38796.280	5.528	11° 23' 36"		
G33-61	-151188.951	-38795.188	2.764	101° 23' 28"		


面積算出公式		面 積	15.2792855	土地の所在	
$A = \frac{1}{2} \sum X_n \times (Y_{n+1} - Y_{n-1})$		地 積	15.27	土地の所有者	

# 座標面積計算書

世界測地系

地番	33BL13LOT	地目	
----	-----------	----	--

境界点	X座標	Y座標	辺長	方向角	備考
G33-22	-151180.157	-38790.583	0.676	191° 25' 34"	
G33-23	-151180.820	-38790.717	8.854	191° 28' 21"	
G33-24	-151189.497	-38792.478	2.764	281° 23' 28"	
G33-61	-151188.951	-38795.188	2.349	281° 23' 28"	
G33-60	-151188.487	-38797.491	5.268	11° 23' 12"	
G33-59	-151183.323	-38796.451	1.123	100° 59' 23"	
G33-58	-151183.537	-38795.349	4.256	11° 24' 37"	
G33-57	-151179.365	-38794.507	4.003	101° 24' 40"	

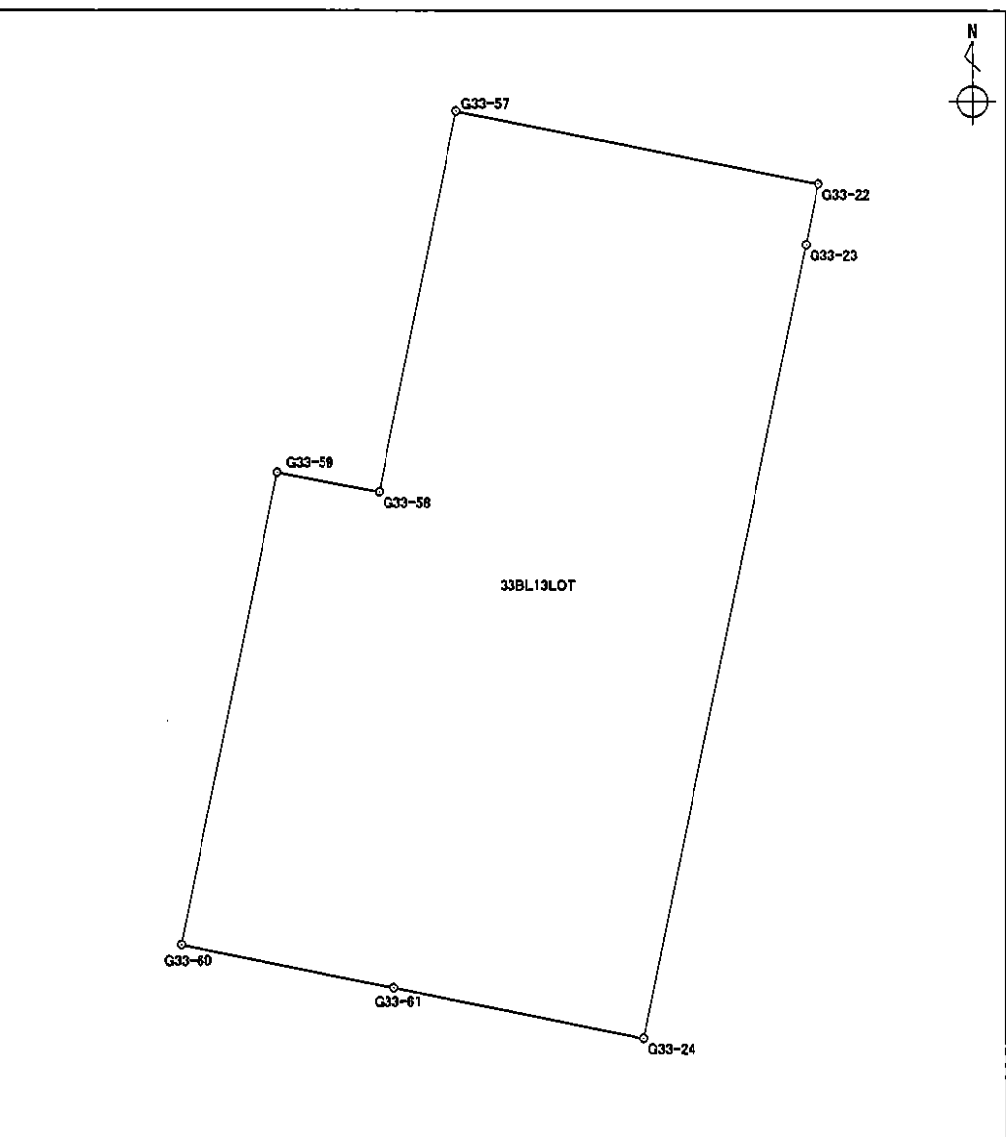


面積算出公式 $A = \frac{1}{2} \sum X_n \times (Y_{n+1} - Y_{n-1})$	面積	44.0215085	土地の所在	
	地積	44.02	土地の所有者	

# 座標面積計算書

地番	33BL14LOT	地目	
----	-----------	----	--

境界点	X座標	Y座標	辺長	方向角	備考
G33-25	-151194.916	-38793.571	6.930	191° 23' 39"	
G33-26	-151201.709	-38794.940	4.003	238° 58' 56"	
G33-27	-151203.772	-38798.371	25.085	286° 42' 48"	
K42	-151196.558	-38822.396	7.323	7° 28' 10"	
G33-63	-151189.297	-38821.444	25.670	101° 23' 52"	
G33-62	-151194.370	-38796.280	2.763	101° 23' 43"	

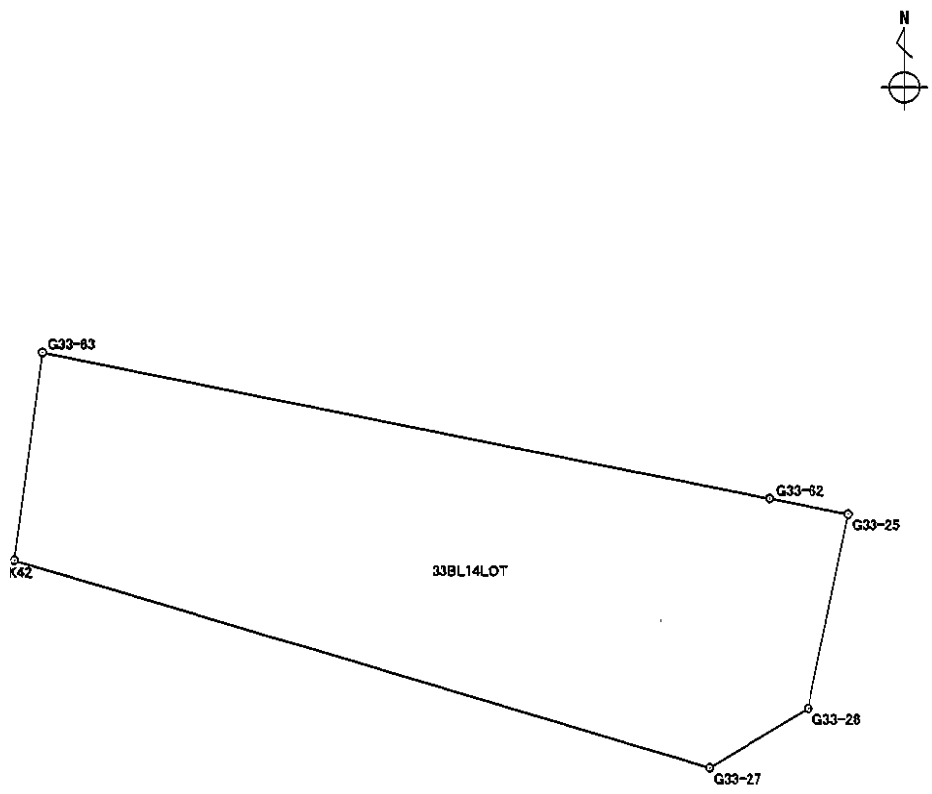


面積算出公式 $A = \frac{1}{2} \sum X_n \times (Y_{n+1} - Y_{n-1})$	面積	237.8035320	土地の所在	
	地積	237.80	土地の所有者	

# 座標面積計算書

<b>地番</b> 33BL15LOT	<b>地目</b> <span style="border: 1px solid black; display: inline-block; width: 80px; height: 15px;"></span>
---------------------	--

境界点	X 座標	Y 座標	辺長	方向角	備考
K42	-151196.558	-38822.396	15.572	284° 55' 33"	
G33-28	-151192.547	-38837.443	5.085	5° 29' 43"	
G33-65	-151187.485	-38836.956	4.965	275° 30' 06"	
G33-66	-151187.009	-38841.898	24.128	5° 29' 55"	
G33-67	-151162.992	-38839.586	1.936	274° 08' 48"	
G33-68	-151162.852	-38841.517	6.072	0° 35' 40"	
G33-45	-151156.780	-38841.454	2.425	97° 06' 27"	
G33-46	-151157.080	-38839.048	4.918	97° 06' 07"	
G33-47	-151157.688	-38834.168	7.554	102° 22' 36"	
G33-48	-151159.307	-38826.790	9.631	102° 22' 52"	
G33-49	-151161.372	-38817.383	5.063	191° 57' 29"	
G33-64	-151166.325	-38818.432	23.169	187° 28' 11"	
G33-63	-151189.297	-38821.444	7.323	187° 28' 10"	

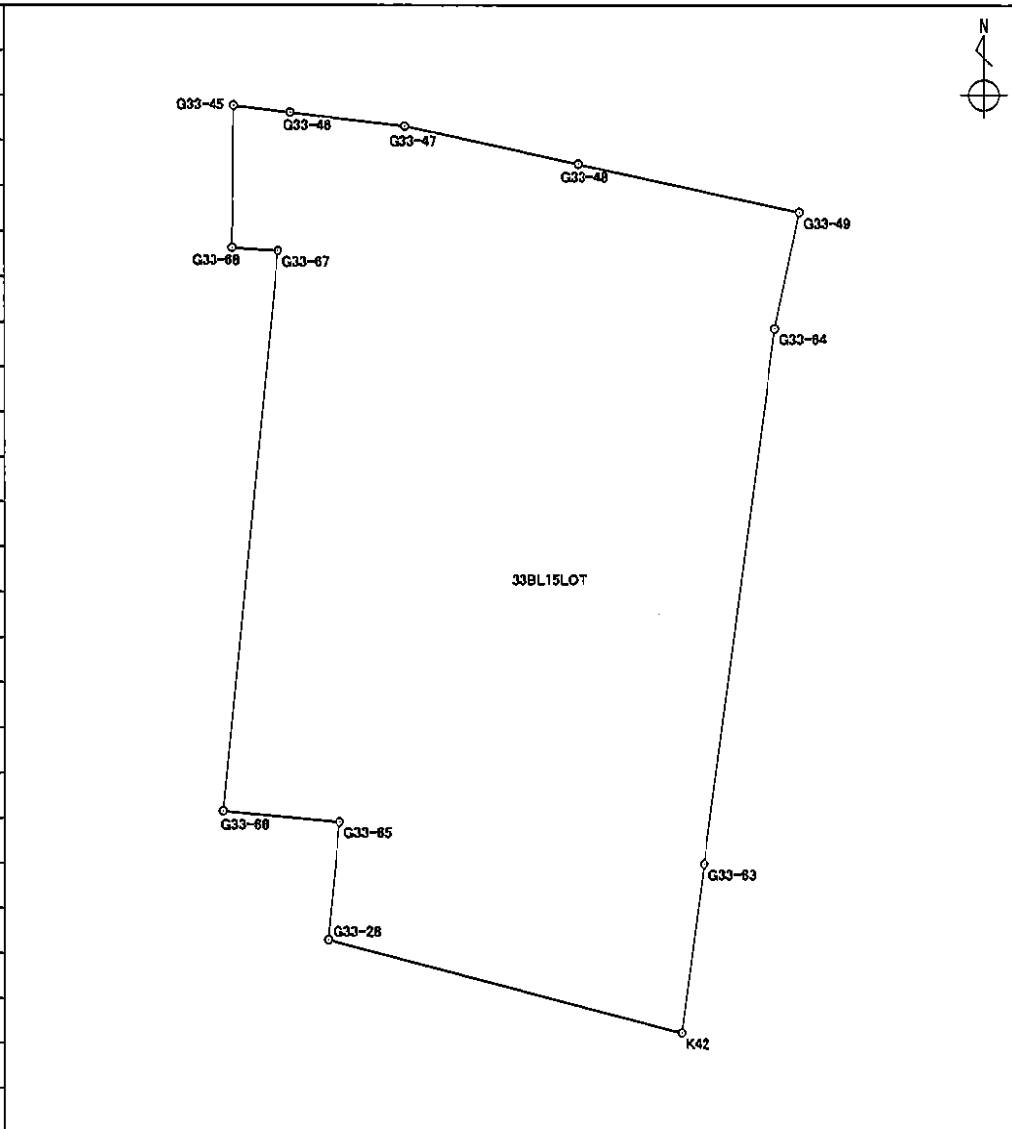

<b>面積算出公式</b>	<b>面積</b>	727.9962245	<b>土地の所在</b>	
$A = \frac{1}{2} \sum X_n \times (Y_{n+1} - Y_{n-1})$	<b>地積</b>	727.99	<b>土地の所有者</b>	




# 座 標 面 積 計 算 書

世界測地系

地番	33BL16LOT	地目	
----	-----------	----	--

境界点	X座標	Y座標	辺長	方向角	備考
G33-28	-151192.547	-38837.443	0.483	284° 52' 13"	
K42-1	-151192.423	-38837.910	4.544	284° 27' 08"	
K43	-151191.289	-38842.310	4.300	5° 29' 54"	
G33-66	-151187.009	-38841.898	4.965	95° 30' 06"	
G33-65	-151187.485	-38836.956	5.085	185° 29' 43"	

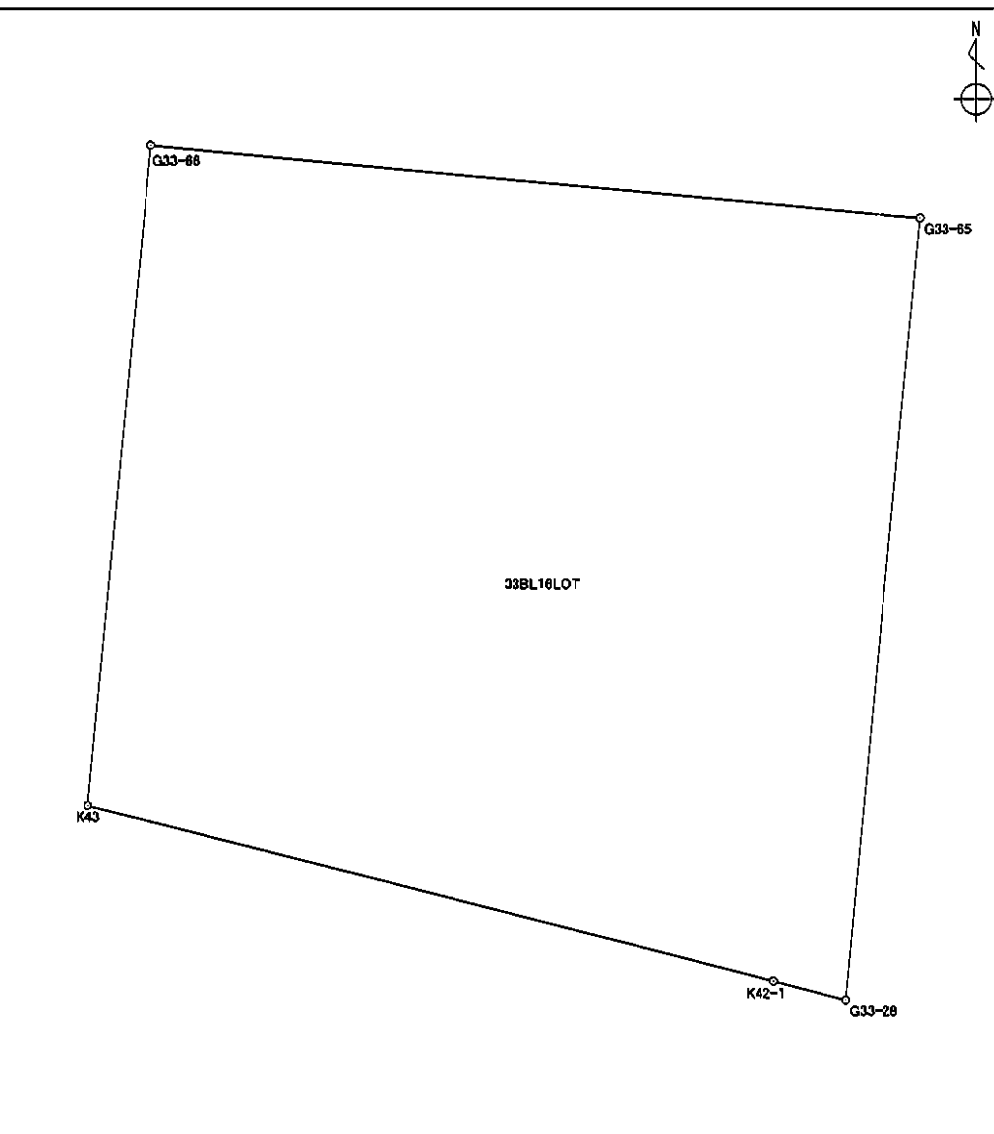


面積算出公式		面積	23.2906250	土地の所在	
$A = \frac{1}{2} \sum X_n \times (Y_{n+1} - Y_{n-1})$		地積	23.29	土地の所有者	

世界測地系

# 座標面積計算書

地番 33BL17LOT 地目

境界点	X座標	Y座標	辺長	方向角	備考
K43	-151191.289	-38842.310	0.664	281° 38' 55"	
K43-1	-151191.155	-38842.960	19.182	280° 26' 26"	
G33-29	-151187.679	-38861.824	26.853	6° 45' 30"	
G33-69	-151161.013	-38858.664	17.245	96° 07' 17"	
G33-68	-151162.852	-38841.517	1.936	94° 08' 48"	
G33-67	-151162.992	-38839.586	24.128	185° 29' 55"	
G33-66	-151187.009	-38841.898	4.300	185° 29' 54"	

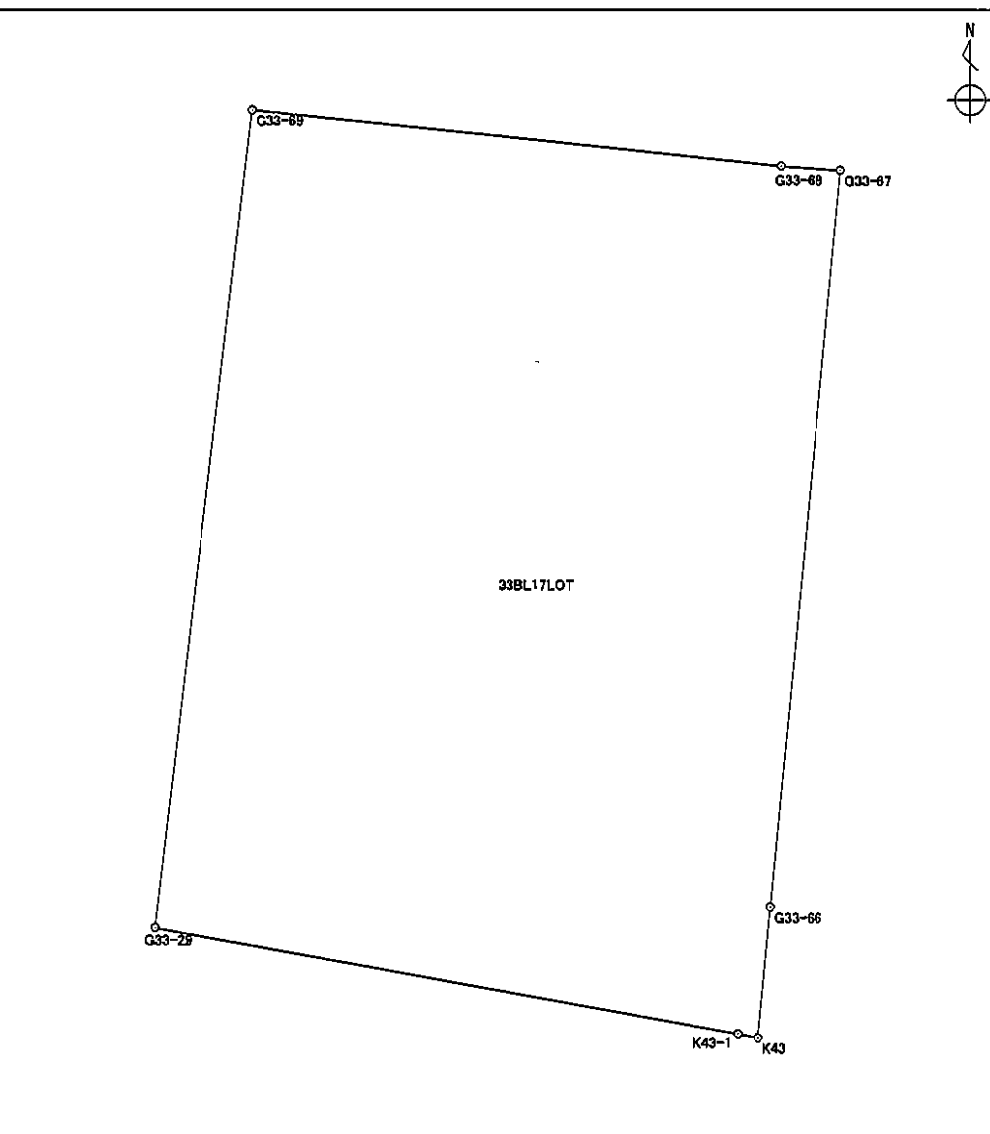


面積算出公式	面積	537.7948125	土地の所在
$A = \frac{1}{2} \sum X_n \times (Y_{n+1} - Y_{n-1})$	地積	537.79	土地の所有者

# 座 標 面 積 計 算 書

世界測地系

地番 33BL18LOT | 地目

境 界 点	X 座 標	Y 座 標	辺 長	方 向 角	備 考
G33-29	-151187.679	-38861.824	0.509	280° 24' 20"	
K44	-151187.587	-38862.325	2.015	285° 41' 30"	
K45	-151187.042	-38864.265	0.141	279° 23' 44"	
G33-73	-151187.019	-38864.404	26.475	7° 22' 58"	
G33-71	-151160.763	-38861.002	2.351	96° 06' 12"	
G33-69	-151161.013	-38858.664	26.853	186° 45' 30"	

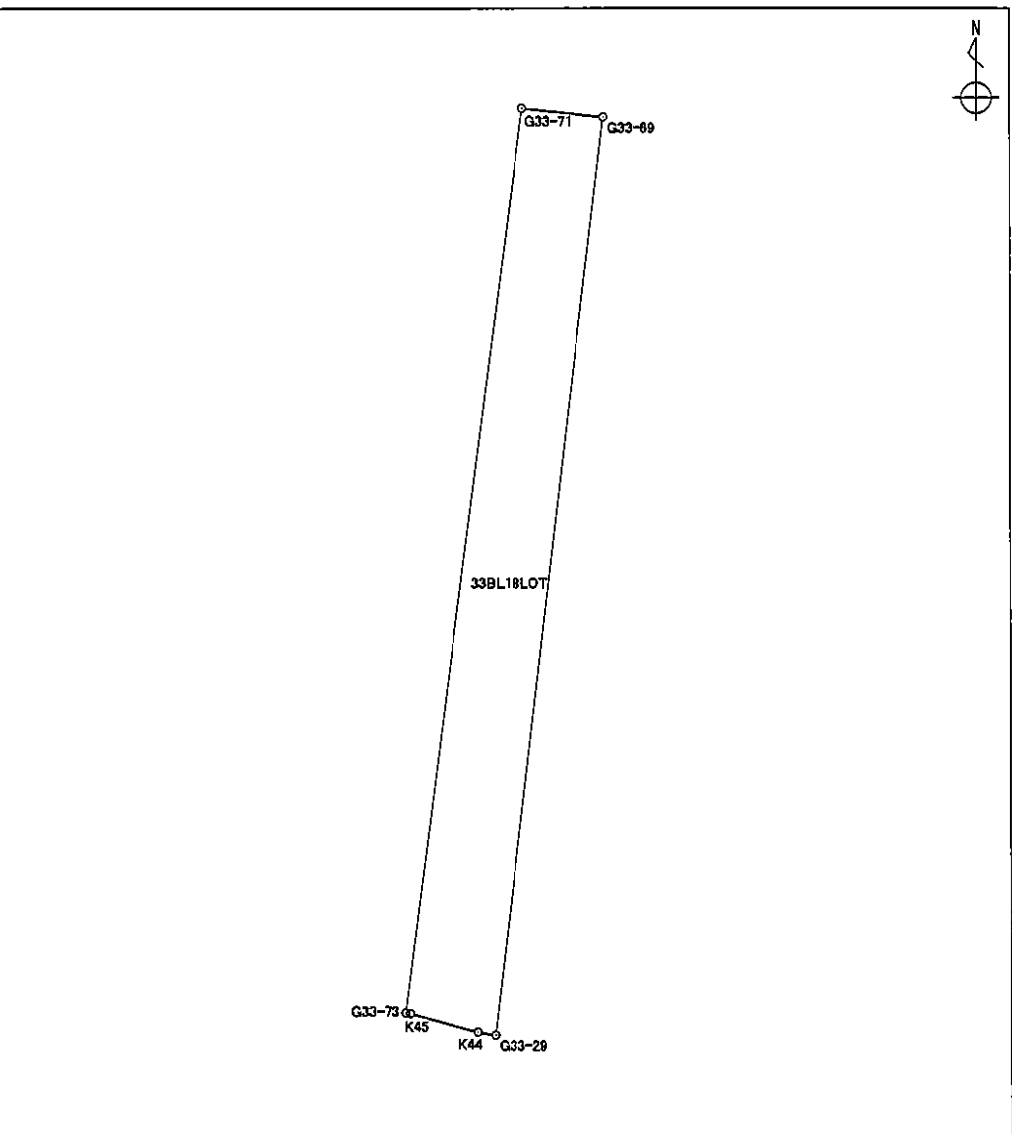

面積算出公式 $A = \frac{1}{2} \sum X_n \times (Y_{n+1} - Y_{n-1})$	面 積	66.5915365	土地の所在	
	地 積	66.59	土地の所有者	

# 座 標 面 積 計 算 書

世界測地系

地番	33BL19LOT	地目	
----	-----------	----	--

境界点	X 座標	Y 座標	辺長	方向角	備考	
G33-73	-151187.019	-38864.404	13.360	279° 24' 31"		
G33-30	-151184.835	-38877.584	3.990	323° 42' 58"		
G33-31	-151181.619	-38879.945	22.763	7° 22' 58"		
G33-32	-151159.045	-38877.020	16.110	96° 07' 19"		
G33-71	-151160.763	-38861.002	26.475	187° 22' 58"		

面積算出公式		面積	415.1306170	土地の所在	
$A = \frac{1}{2} \sum X_n \times (Y_{n+1} - Y_{n-1})$		地積	415.13	土地の所有者	


# 座標面積計算書

世界測地系

地番 33BL20LOT

地目

境界点	X 座標	Y 座標	辺長	方向角	備考
G33-32	-151159.045	-38877.020	5.218	7° 29' 19"	
G33-33	-151153.872	-38876.340	15.520	94° 46' 44"	
G33-43	-151155.165	-38860.874	2.885	94° 45' 08"	
G33-76	-151155.404	-38857.999	5.648	186° 45' 41"	
G33-69	-151161.013	-38858.664	2.351	276° 06' 12"	
G33-71	-151160.763	-38861.002	16.110	276° 07' 19"	

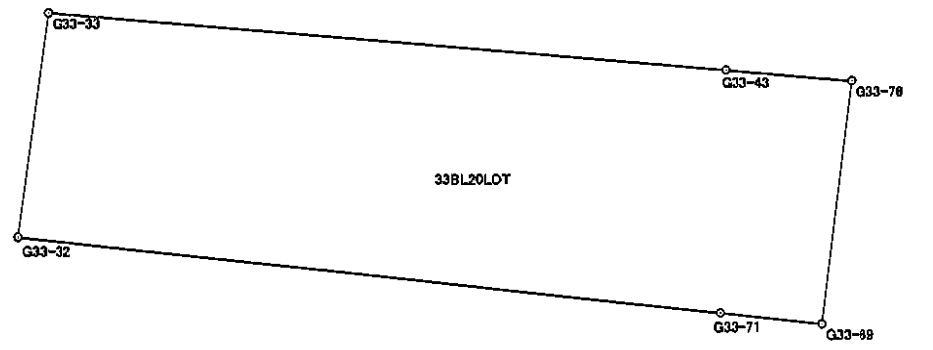


面積算出公式	面積	100.0892300	土地の所在	
$A = \frac{1}{2} \sum X_n \times (Y_{n+1} - Y_{n-1})$	地積	100.08	土地の所有者	

# 座 標 面 積 計 算 書

世界測地系

地番	33BL21LOT	地目	
----	-----------	----	--

境 界 点	X 座 標	Y 座 標	辺 長	方 向 角	備 考
G33-33	-151153.872	-38876.340	14.176	7° 27' 28"	
G33-34	-151139.816	-38874.500	15.494	97° 27' 01"	
G33-42	-151141.825	-38859.137	13.453	187° 25' 07"	
G33-43	-151155.165	-38860.874	15.520	274° 46' 44"	

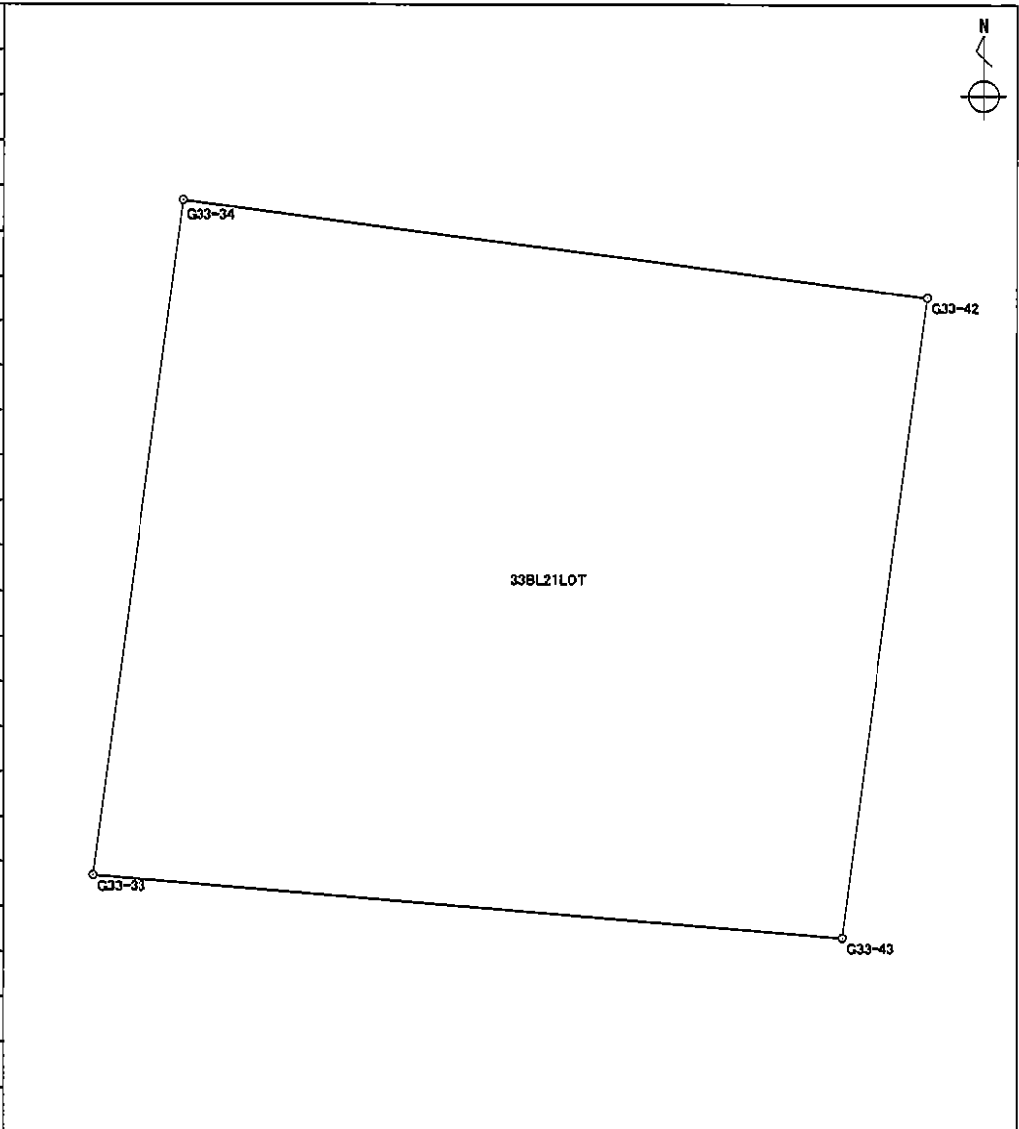

面積算出公式		面 積	214.1006345	土地の所在	
$A = \frac{1}{2} \sum X_n \times (Y_{n+1} - Y_{n-1})$		地 積	214.10	土地の所有者	


# 座 標 面 積 計 算 書

世界測地系

地番 33BL22LOT

地目

境界点	X 座標	Y 座標	辺長	方向角	備考
G33-74	-151150.786	-38784.685	1.712	191° 25' 17"	
G33-15	-151152.464	-38785.024	1.494	191° 25' 49"	
G33-16	-151153.928	-38785.320	14.276	280° 01' 28"	
G33-55	-151151.443	-38799.378	3.205	10° 01' 36"	
G33-75	-151148.287	-38798.820	14.354	100° 01' 34"	

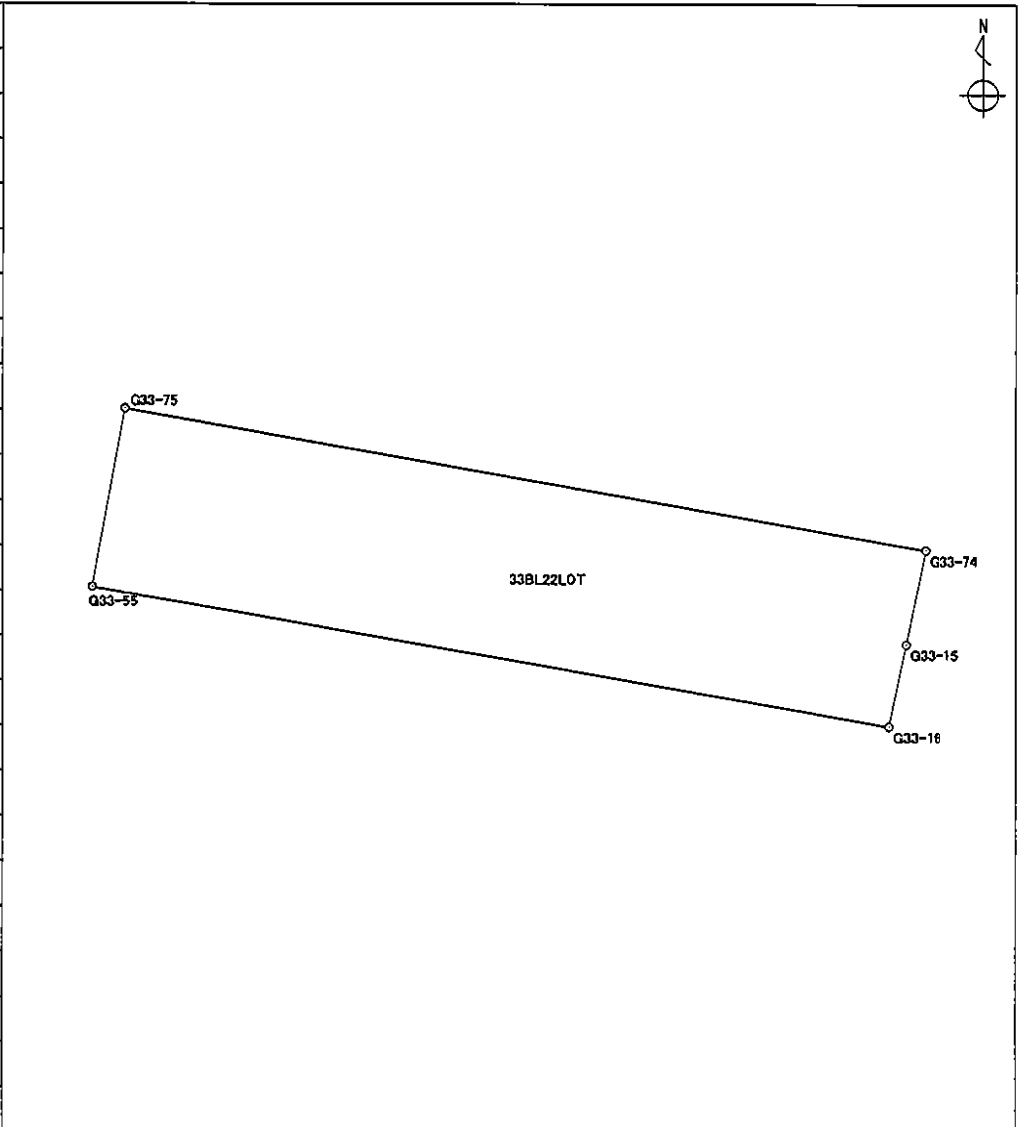


面積算出公式 $A = \frac{1}{2} \sum X_n \times (Y_{n+1} - Y_{n-1})$	面 積	45.876525
	地 積	45.87

土地の所在	
土地の所有者	

座標面積計算書

地番	33BL23LOT	地目	
----	-----------	----	--

境界点	X座標	Y座標	辺長	方向角	備考
G33-69	-151161.013	-38858.664	5.648	6° 45' 41"	
G33-76	-151155.404	-38857.999	16.304	94° 45' 11"	
G33-44	-151156.755	-38841.751	0.298	94° 48' 42"	
G33-45	-151156.780	-38841.454	6.072	180° 35' 40"	
G33-68	-151162.852	-38841.517	17.245	276° 07' 17"	

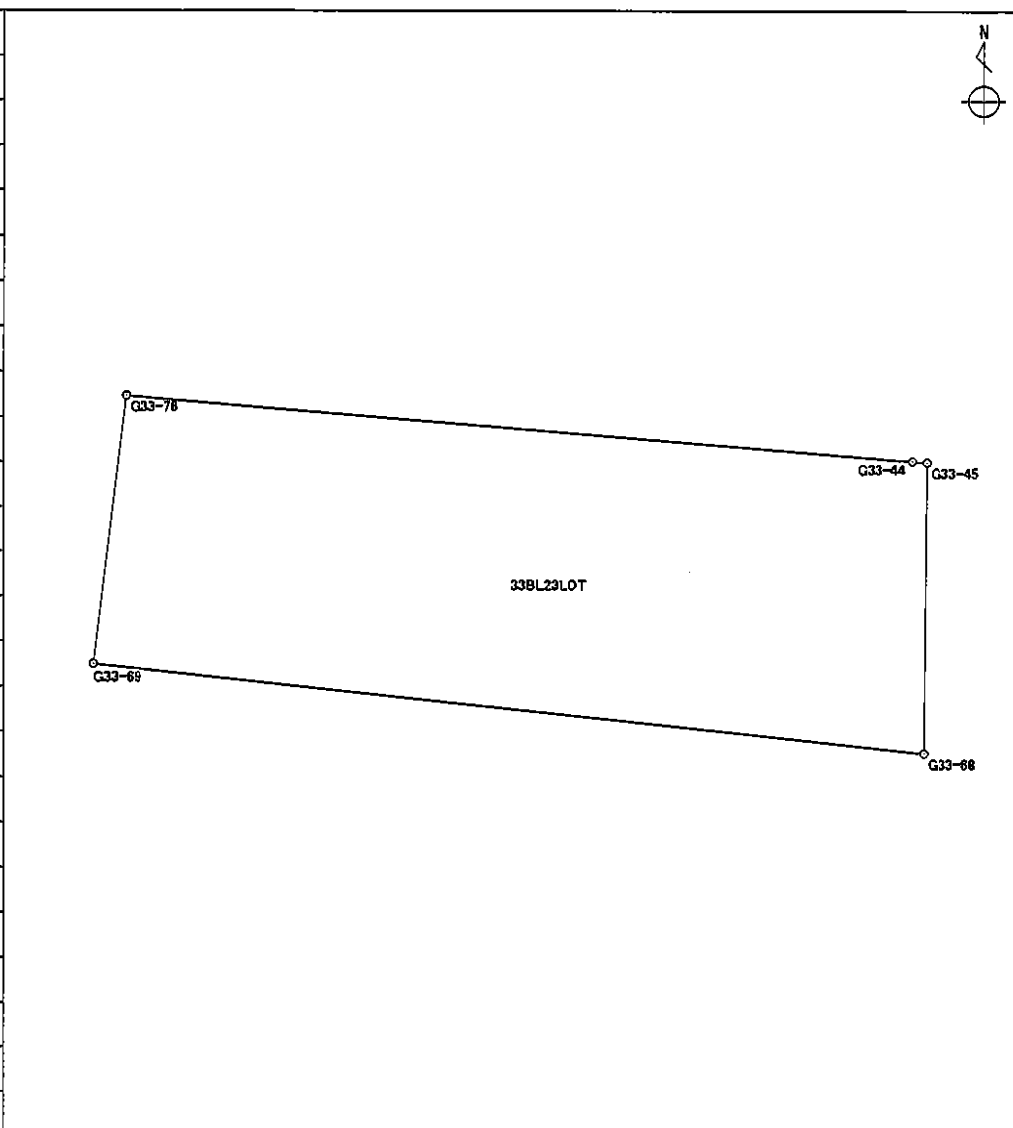

面積算出公式 $A = \frac{1}{2} \sum X_n \times (Y_{n+1} - Y_{n-1})$	面積	98.9766695	土地の所在	
	地積	98.97	土地の所有者	