

面 積 集 計 表

平成 19 年 2 月 2 日

現場名：平成18年度出来形確認測量

所 有 者	No.	地番No	地 番 名	面 積	地 積	坪 数
	1	20	8BL公園	2999.0687965	2999.06	907.21
	2	164	8BL11.0T	7.2525720	7.25	2.19
	3	165	8BL2LOT	32.0793445	32.07	9.70
	4	166	8BL3LOT	10.9938645	10.99	3.32
	5	167	8BL4LOT	23.0166760	23.01	6.96
	6	168	8BL5LOT	171.1379100	171.13	51.76
	7	169	8BL6LOT	581.8656900	581.86	176.01
	8	170	8BL7LOT	36.7185980	36.71	11.10
	9	171	8BL8LOT	241.0064220	241.00	72.90
	10	23	8BL水路	23.9361200	23.93	7.24


合 計			10筆	4127.0759935	4127.01	1248.39
-----	--	--	-----	--------------	---------	---------

座標面積計算書

世界測地系

地番	8BL公園	地目
----	-------	----

境界点	X座標	Y座標	辺長	方向角	備考
G8-1	-150679.995	-38712.200	4.009	72° 27' 52"	
G8-2	-150678.787	-38708.377	2.138	114° 38' 05"	
G8-3	-150679.678	-38706.434	2.020	114° 32' 08"	
G8-4	-150680.517	-38704.596	3.020	112° 39' 02"	
G8-5	-150681.680	-38701.809	1.995	111° 46' 10"	
G8-6	-150682.420	-38699.956	2.023	110° 56' 38"	
G8-7	-150683.143	-38698.067	2.008	109° 51' 05"	
G8-8	-150683.825	-38696.178	1.999	109° 04' 10"	
G8-9	-150684.478	-38694.289	2.014	107° 54' 15"	
G8-10	-150685.097	-38692.373	2.008	107° 05' 25"	
G8-11	-150685.687	-38690.454	2.010	106° 23' 17"	
G8-12	-150686.254	-38688.526	4.007	139° 07' 44"	
G8-13	-150689.284	-38685.904	44.991	172° 49' 13"	
G8-14	-150733.922	-38680.281	2.847	271° 28' 10"	
G8-55	-150733.849	-38683.127	2.396	181° 17' 30"	
G8-56	-150736.244	-38683.181	5.731	271° 22' 12"	
G8-57	-150736.107	-38688.910	3.472	181° 40' 00"	
G8-58	-150739.578	-38689.011	1.153	181° 23' 28"	
G8-61	-150740.731	-38689.039	2.341	181° 22' 15"	
G8-59	-150743.071	-38689.095	10.012	91° 28' 15"	
G8-17	-150743.328	-38679.086	4.048	172° 39' 45"	
G8-18	-150747.343	-38678.569	11.846	271° 27' 22"	
G8-62	-150747.042	-38690.411	37.855	271° 27' 22"	
G8-63	-150746.080	-38728.254	2.392	271° 27' 41"	

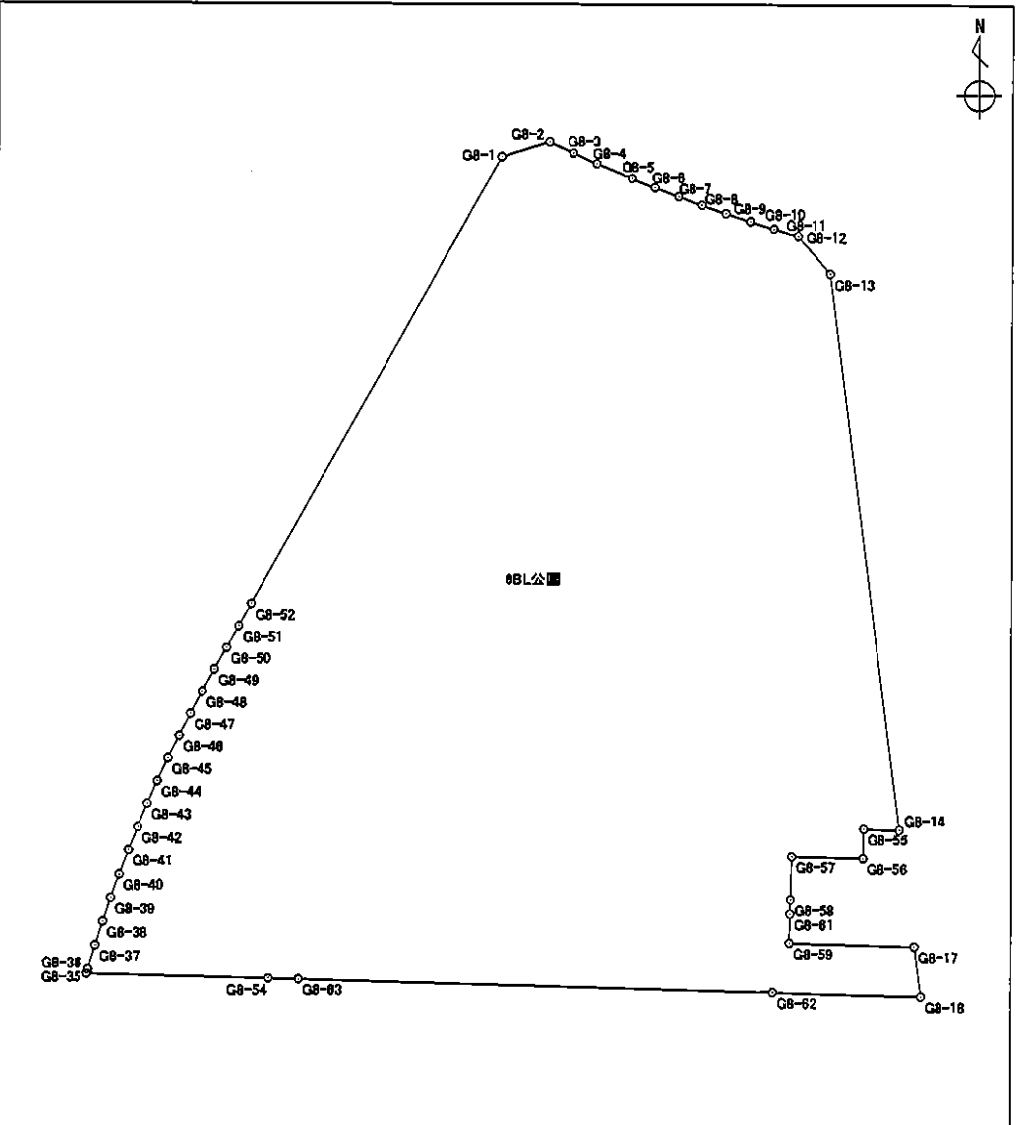


面積算出公式	面積		土地の所在	
$A = \frac{1}{2} \sum X_n \times (Y_{n+1} - Y_{n-1})$	地積		土地の所有者	

座標面積計算書

世界測地系

地番	8BL公園	地目
----	-------	----

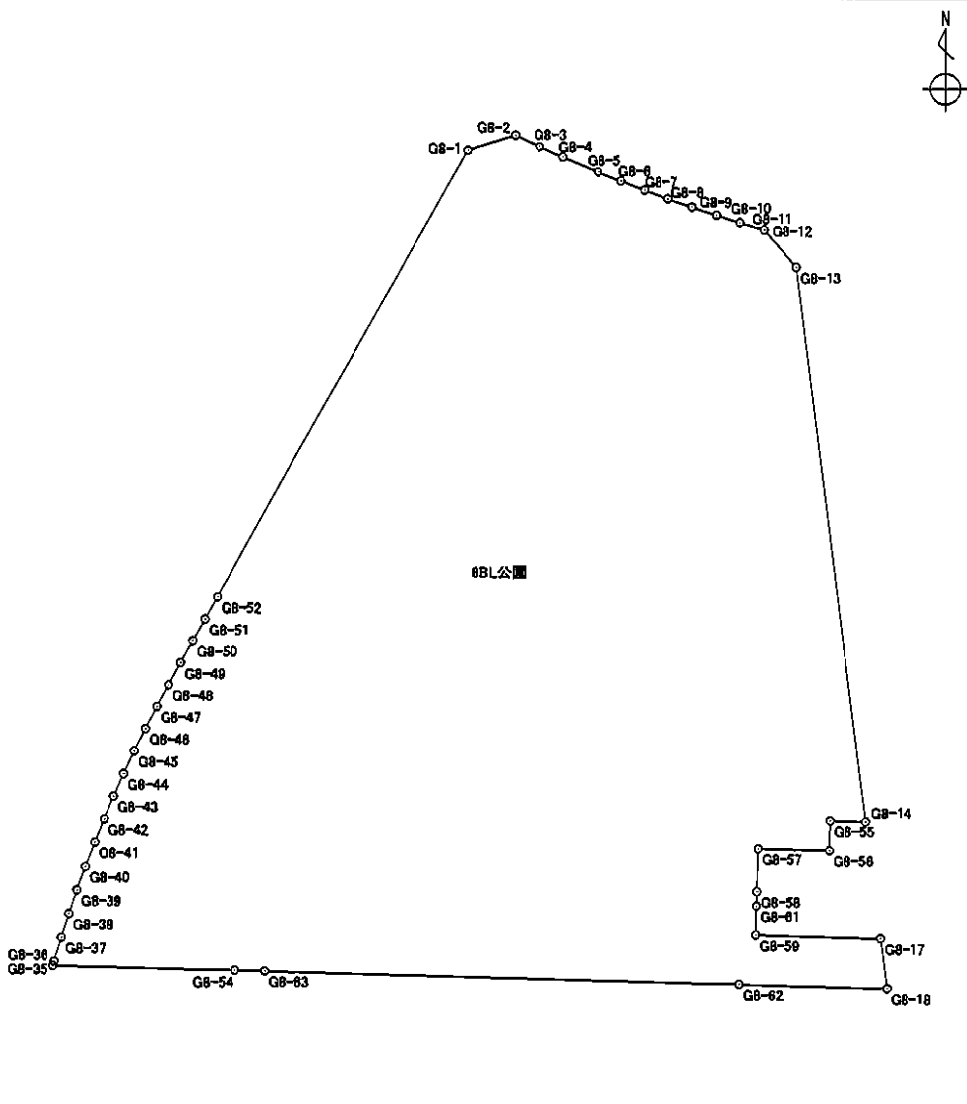
境界点	X座標	Y座標	辺長	方向角	備考		
G8-54	-150746.019	-38730.645	14.462	271° 20' 35"			
G8-35	-150745.680	-38745.103	0.359	15° 00' 12"			
G8-36	-150745.333	-38745.010	2.002	16° 25' 30"			
G8-37	-150743.413	-38744.444	1.995	17° 11' 59"			
G8-38	-150741.507	-38743.854	2.004	18° 08' 44"			
G8-39	-150739.603	-38743.230	2.000	19° 21' 32"			
G8-40	-150737.716	-38742.567	2.112	20° 20' 24"			
G8-41	-150735.736	-38741.833	2.008	21° 35' 41"			
G8-42	-150733.869	-38741.094	1.999	22° 29' 55"			
G8-43	-150732.022	-38740.329	1.999	23° 39' 14"			
G8-44	-150730.191	-38739.527	2.005	24° 53' 27"			
G8-45	-150728.372	-38738.683	2.003	26° 23' 09"			
G8-46	-150726.578	-38737.793	1.995	26° 40' 50"			
G8-47	-150724.795	-38736.897	2.013	28° 04' 03"			
G8-48	-150723.019	-38735.950	2.006	28° 35' 48"			
G8-49	-150721.258	-38734.990	2.004	28° 42' 47"			
G8-50	-150719.500	-38734.027	1.997	28° 51' 44"			
G8-51	-150717.751	-38733.063	2.011	28° 48' 30"			
G8-52	-150715.989	-38732.094	41.126	28° 55' 46"			
面積算出公式			面積		2999.0687965		土地の所在
$A = \frac{1}{2} \sum X_n \times (Y_{n+1} - Y_{n-1})$			地積		2999.06		土地の所有者

座 標 面 積 計 算 書

世界測地系

地番	8BL1LOT	地目	
----	---------	----	--

境界点	X 座標	Y 座標	辺長	方向角	備考
G8-14	-150733.922	-38680.281	2.424	172° 44' 56"	
G8-15	-150736.327	-38679.975	3.207	271° 28' 59"	
G8-56	-150736.244	-38683.181	2.396	1° 17' 30"	
G8-55	-150733.849	-38683.127	2.847	91° 28' 10"	

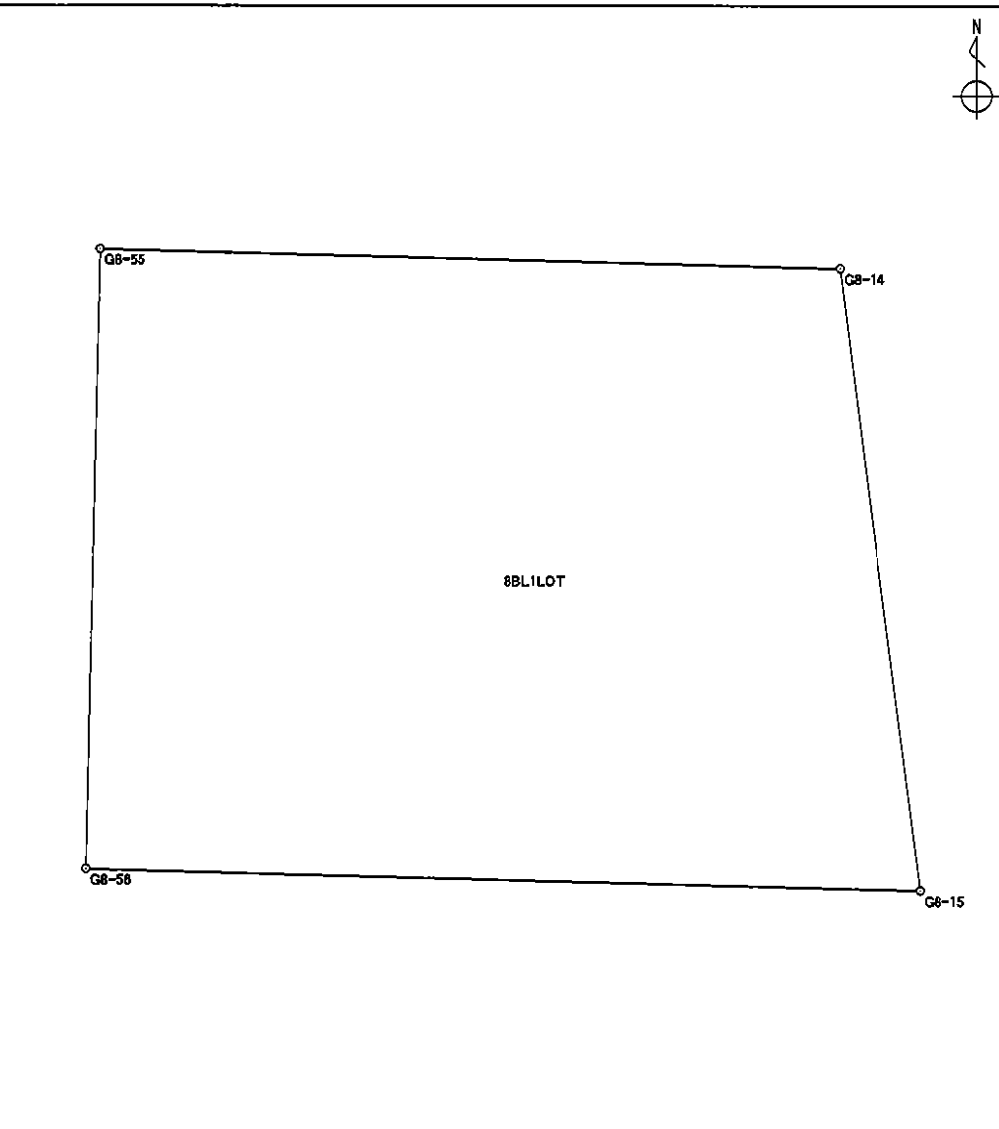

面積算出公式 $A = \frac{1}{2} \sum X_n \times (Y_{n+1} - Y_{n-1})$	面積	7.2525720	土地の所在	
	地積	7.25	土地の所有者	

座標面積計算書

世界測地系

地番	8BL2LOT	地目	
----	---------	----	--


境界点	X座標	Y座標	辺長	方向角	備考				
G8-15	-150736.327	-38679.975	3.531	172° 49' 29"					
G8-16	-150739.830	-38679.534	9.480	271° 31' 23"					
G8-58	-150739.578	-38689.011	3.472	1° 40' 00"					
G8-57	-150736.107	-38688.910	5.731	91° 22' 12"					
G8-56	-150736.244	-38683.181	3.207	91° 28' 59"					
面積算出公式		面積	32.0793445		土地の所在				
$A = \frac{1}{2} \sum X_n \times (Y_{n+1} - Y_{n-1})$		地積	32.07		土地の所有者				

座標面積計算書

世界測地系

地番	SBL3LOT	地目	
----	---------	----	--

境界点	X座標	Y座標	辺長	方向角	備考
G8-16	-150739.830	-38679.534	1.158	172° 42' 34"	
G8-60	-150740.979	-38679.387	9.655	271° 28' 19"	
G8-61	-150740.731	-38689.039	1.153	1° 23' 28"	
G8-58	-150739.578	-38689.011	9.480	91° 31' 23"	

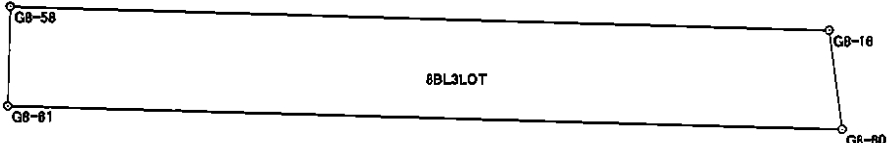


面積算出公式 $A = \frac{1}{2} \sum X_n \times (Y_{n+1} - Y_{n-1})$	面積	10.9938645	土地の所在	
	地積	10.99	土地の所有者	

座標面積計算書

世界測地系

地番	8BL4LOT	地目	
----	---------	----	--

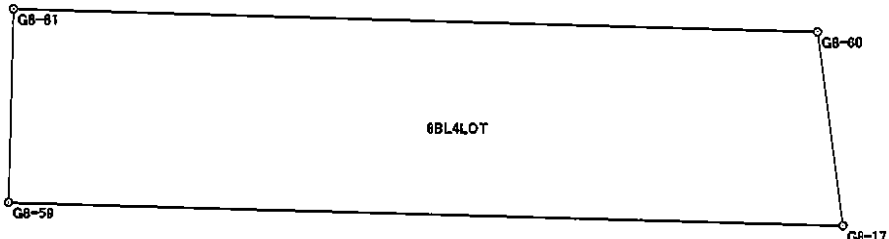
境界点	X座標	Y座標	辺長	方向角	備考	
G8-60	-150740.979	-38679.387	2.368	172° 41' 53"		
G8-17	-150743.328	-38679.086	10.012	271° 28' 15"		
G8-59	-150743.071	-38689.095	2.341	1° 22' 15"		
G8-61	-150740.731	-38689.039	9.655	91° 28' 19"		
面積算出公式		面積	23.0166760		土地の所在	
$A = \frac{1}{2} \sum X_n \times (Y_{n+1} - Y_{n-1})$		地積	23.01		土地の所有者	

座標面積計算書

世界測地系

地番	8BL5LOT	地目	
----	---------	----	--

境界点	X座標	Y座標	辺長	方向角	備考
G8-18	-150747.343	-38678.569	3.256	172° 52' 22"	
G8-19	-150750.574	-38678.165	2.342	271° 35' 26"	
G8-53	-150750.509	-38680.506	11.516	172° 51' 43"	
G8-21	-150761.936	-38679.075	1.035	223° 54' 16"	
G8-22	-150762.682	-38679.793	11.023	271° 29' 31"	
G8-23	-150762.395	-38690.812	15.358	1° 29' 46"	
G8-62	-150747.042	-38690.411	11.846	91° 27' 22"	

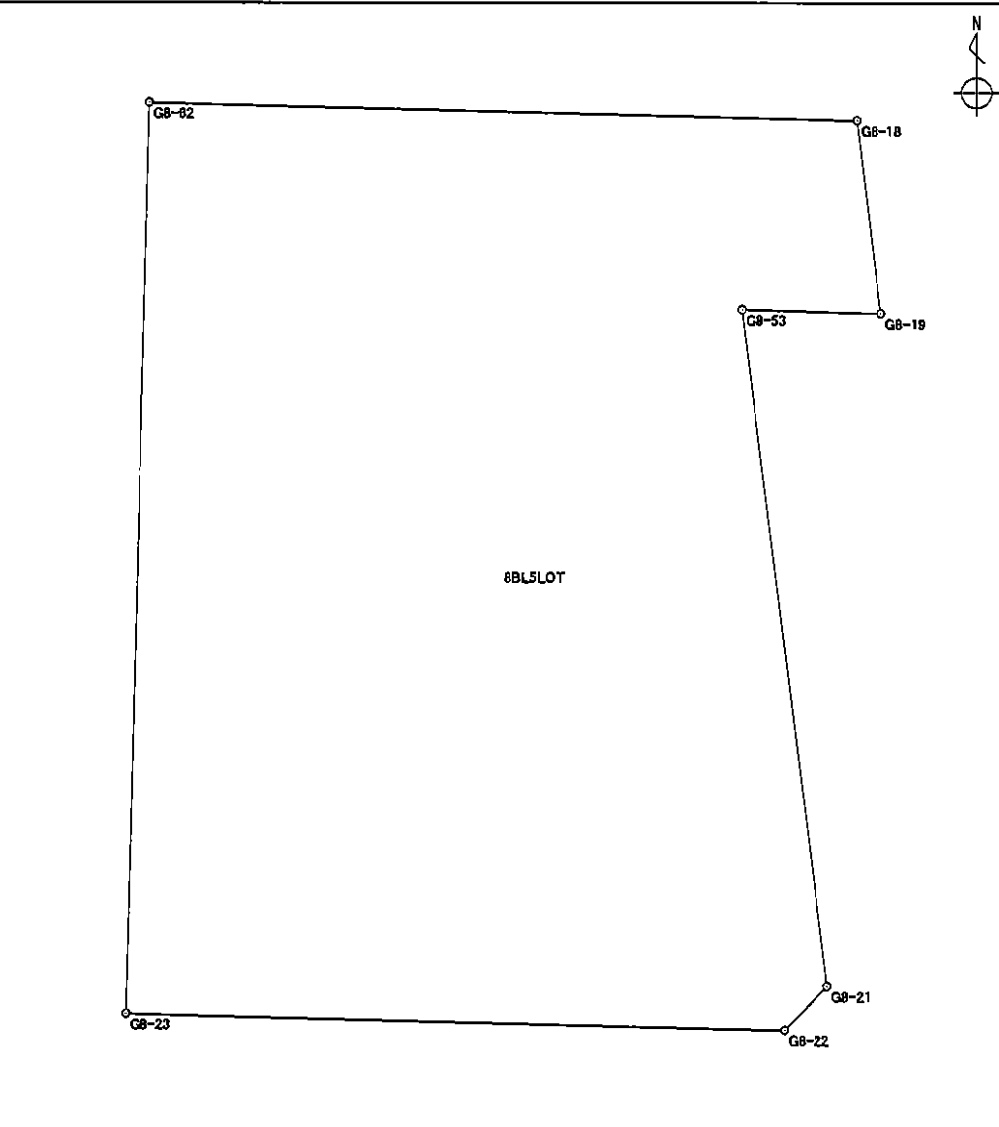


面積算出公式 $A = \frac{1}{2} \sum X_n \times (Y_{n+1} - Y_{n-1})$	面積 地積	171.1379100 171.13	土地の所在 土地の所有者
---	----------	-----------------------	-----------------

座 標 面 積 計 算 書

地番 8BL6LOT	地目	
------------	----	--

境 界 点	X 座 標	Y 座 標	辺 長	方 向 角	備 考
G8-23	-150762.395	-38690.812	4.244	271° 29' 55"	
G8-24	-150762.284	-38695.055	10.016	271° 19' 59"	
G8-25	-150762.051	-38705.068	23.580	271° 26' 19"	
G8-26	-150761.459	-38728.641	15.384	1° 26' 29"	
G8-63	-150746.080	-38728.254	37.855	91° 27' 22"	
G8-62	-150747.042	-38690.411	15.358	181° 29' 46"	

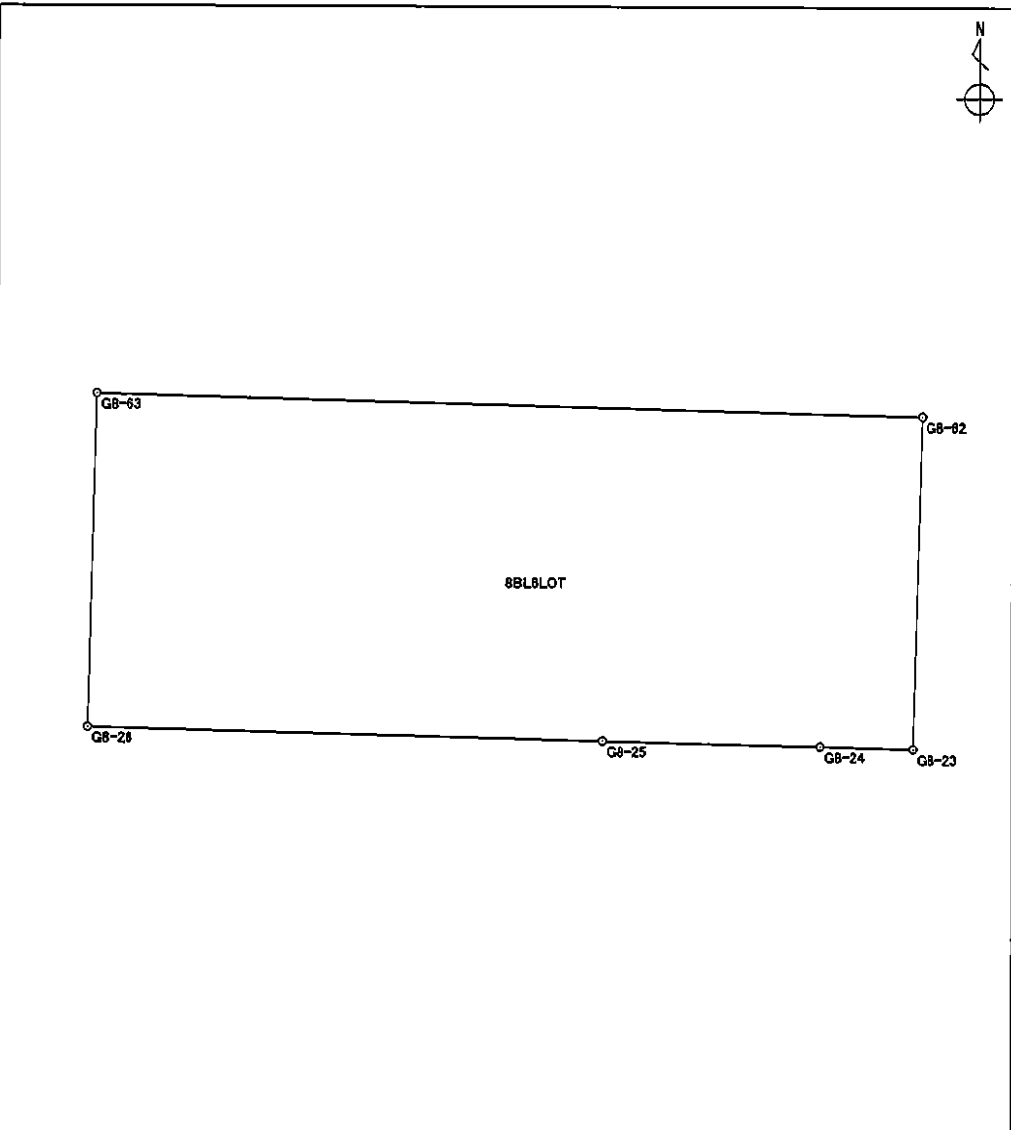

面積算出公式	面 積	581.8656900	土地の所在
$A = \frac{1}{2} \sum X_n \times (Y_{n+1} - Y_{n-1})$	地 積	581.86	土地の所有者

座標面積計算書

世界測地系

地番	8BL7LOT	地目	
----	---------	----	--


境界点	X座標	Y座標	辺長	方向角	備考	
G8-26	-150761.459	-38728.641	2.382	271° 26' 37"		
G8-27	-150761.399	-38731.022	15.385	1° 24' 15"		
G8-54	-150746.019	-38730.645	2.392	91° 27' 41"		
G8-63	-150746.080	-38728.254	15.384	181° 26' 29"		
面積算出公式		面積		36.7185980		土地の所在
$A = \frac{1}{2} \sum X_n \times (Y_{n+1} - Y_{n-1})$		地積		36.71		土地の所有者

座 標 面 積 計 算 書

世界測地系

地番	8BLSLOT	地目	
----	---------	----	--

境界点	X 座標	Y 座標	辺長	方向角	備考
G8-27	-150761.399	-38731.022	14.087	271° 22' 59"	
G8-28	-150761.059	-38745.105	4.034	319° 58' 02"	
G8-29	-150757.970	-38747.700	2.908	9° 26' 23"	
G8-30	-150755.101	-38747.223	2.004	10° 15' 41"	
G8-31	-150753.129	-38746.866	2.000	11° 55' 00"	
G8-32	-150751.172	-38746.453	2.000	12° 45' 54"	
G8-33	-150749.221	-38746.011	2.008	14° 05' 30"	
G8-34	-150747.273	-38745.522	1.647	14° 44' 11"	
G8-35	-150745.680	-38745.103	14.462	91° 20' 35"	
G8-54	-150746.019	-38730.645	15.385	181° 24' 15"	

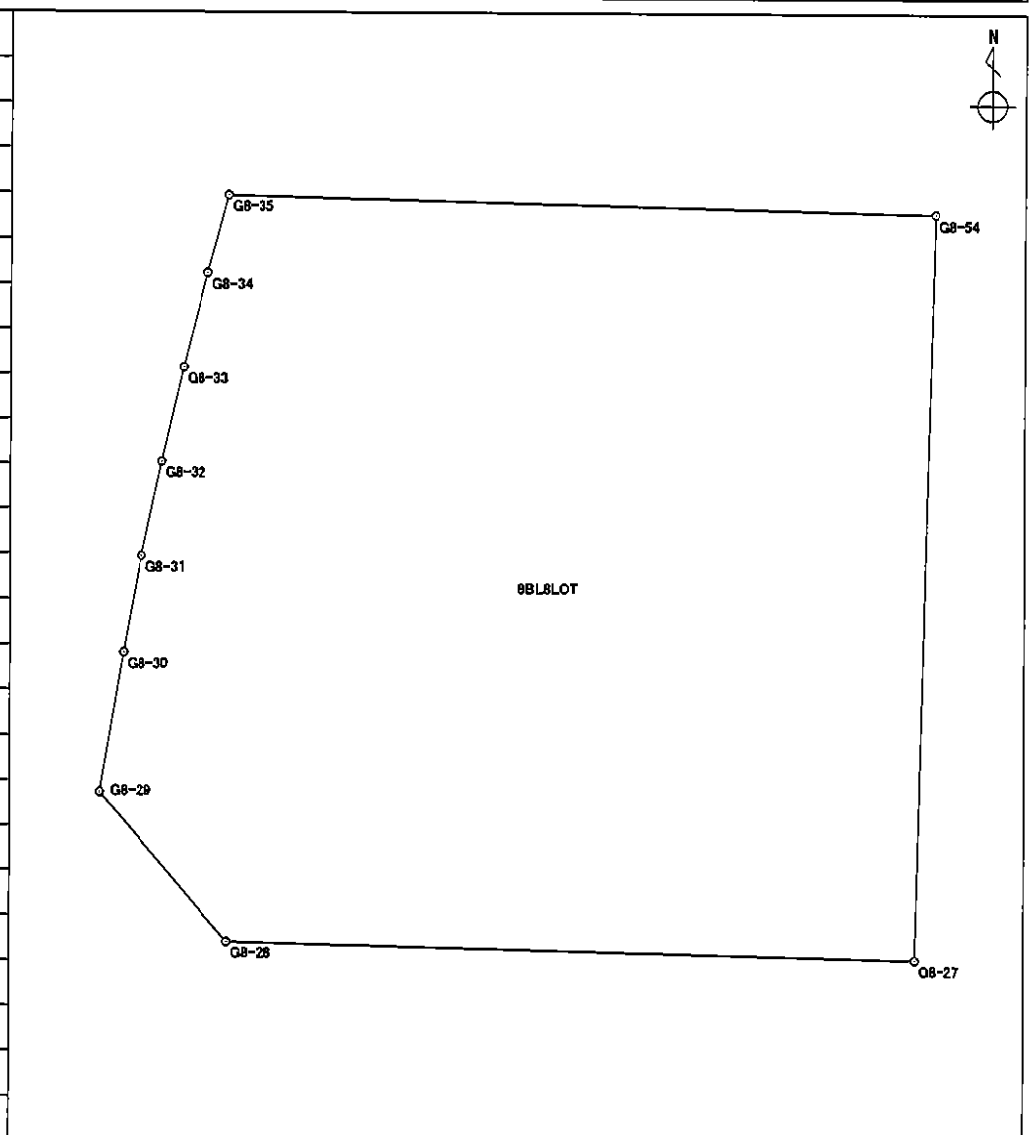

面積算出公式 $A = \frac{1}{2} \sum X_n \times (Y_{n+1} - Y_{n-1})$	面 積	241.0064220	土地の所在	
	地 積	241.00	土地の所有者	

座標面積計算書

世界測地系

地番	8BL水路	地目	
----	-------	----	--

境界点	X座標	Y座標	辺長	方向角	備考	
G8-19	-150750.574	-38678.165	9.224	172° 56' 17"		
G8-20	-150759.728	-38677.031	3.009	222° 47' 28"		
G8-21	-150761.936	-38679.075	11.516	352° 51' 43"		
G8-53	-150750.509	-38680.506	2.342	91° 35' 26"		
面積算出公式			面積		23.9361200	
$A = \frac{1}{2} \sum X_n \times (Y_{n+1} - Y_{n-1})$			地積		23.93	土地の所有者